

Sumner

KANSAS

SECTION 15 TOWNSHIP 31 RANGE 2E

WELL NO. #1 Dalley

COMPANY Aurora Gasoline

NORTH

				0			

WEST

EAST

SOUTH

Sumner

KANSAS

SEC. 15	TWP. 31	R. 2E
------------	------------	----------

WELL NO. #1 Dalley FARM

COMPANY Aurora Gasoline

CONTRACTOR


WILDCAT

_____ FT. FROM N. LINE

_____ FT. FROM S. LINE

_____ FT. FROM E. LINE

_____ FT. FROM W. LINE

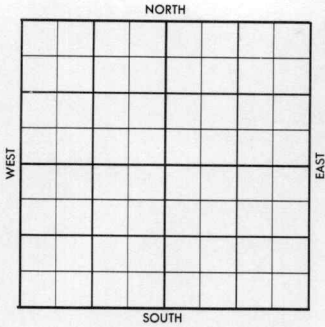

NW NW NE

1956	ELEVATION 1179'	REPORT
------	--------------------	--------

5-23 Cellar & pits
 7-3 Spud 6-16-56
 8 5/8" @ 111 w/150
 DST 3621-28 op 30 min, rec. 100' SWOM
 FP O#. BHP 255/20"
 D & A
 Stall 2256'; KC. 2624', BKC 2877';
 Peru 2914', M. Li. 3196', K. 3549',
 S. 3620', A. 3636'.
 Log tops:
 Stall. 2256', KC. 2622', BKC 2872',
 M. Li. 3196', K. 3547', S. 3618',
 A. 3636'.
 TD 3692'

ABANDONED

County Sumner Elev. 1179
 Sec. 15 Twp. 31 Rge. 2E
 Company Aurora Gasoline
 Farm Name Dalley No. 1

TOPS	DEPTH	LOG	DATUM
Anh.			
Tp.			
H.			
Tr.			
Dg.			
Bl.			
L.			
K.C.			
B.K.C.			
Ce.			
C.			
M.			
M.			
K.			
Mz.			
Me.			
V.			
S.			
S.			
A.			
R.			
PE.			
G.			
T.D.			

Loc. in Sec. NW NW NE

Geol. _____
 Contr. _____

Pool Wildcat

10

FIRST REPORT

MAY 23 '56

Date Comm. Cellar & pits

deet C S YAM

R.G.

Co.

Loc.

No.

Sec.

T.

R.

County Sumner Elev. 1179
 Sec. 15 Twp. 31 Rge. 2E
 Company Aurora Gasoline
 Farm Name Dalley No. 1

TOPS	DEPTH	LOG	DATUM	Loc. in Sec.
Anh.				NW NW NE
Tp. <u>Stall</u>	<u>2256</u>	<u>2256</u>		
H.				Geol.
Tr.				
Dg.				Contr.
Bl.				
L.				Pool
K.C.	<u>2624</u>	<u>2622</u>		
B.K.C.	<u>2877</u>	<u>2872</u>		Wildcat
Ce. <u>Peru</u>	<u>2914</u>			
C.				A BANDONED
M. <u>L1</u>	<u>3196</u>	<u>3196</u>		
M.				JUL 3 1956
K.	<u>3547</u>	<u>3547</u>		
Mz.				
Mq.				
V.				
S.	<u>3620</u>	<u>3618</u>		
S.				
A.	<u>3636</u>	<u>3636</u>		
R.				
Pf.				
G.				
T.D.	<u>3692</u>			

Date Comm. Shell DHM
 Cellar & pits MAY 29 '56 JUN JUN 6 '56 JUN 13 '56

JUN 20 '56 6-16-'56 858 111/150
1660 JUN 27 '56 3510 JUL 3 '56
DST 3621-28 30" rec 100'
SWCM FPO BHP 255/20"

D & a