

Butler Co

Map No. Kansas Sec. 27 Twp. 27 R. 7


Well No. 1 Truesdale Farm
Phillips Pet Company

..... Ft. from N. Line

250 Ft. from S. Line

..... Ft. from E. Line

250 Ft. from W. Line

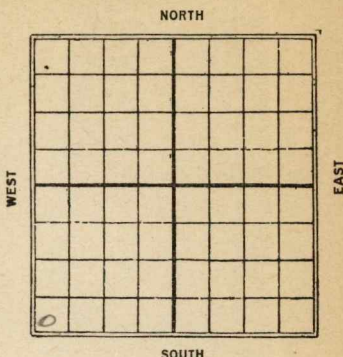

Date	REPORT
1925	
11/13	Location
11/19	Blk 9 Rig
11/27	Rigging up.
12/1	Spud
12/10	dip 275'
12/1	Dip 1075'
12/23	Dip 1330
12/31	Dip 1610'
1926	
1/8	Dip 1925'
1/14	T.S. 2716' show oil. Dip.
1/20	Sand 2721-2752 T.D. 2754
	100 gals 100 Bbl

Bother Co

Map No. *K10* KANSAS Sec. *27* Twp. *27* R. *7*

Well No. *1* *Meddab*

Phillips Pet Co Company

Contractor

FIRST REPORTS

SECTION PLAT

_____ Ft. from N. Line

250 Ft. from S. Line

_____ Ft. from E. Line

250 Ft. from W. Line

<i>o</i>			

Location

Rig up _____

Drilling and Remarks:

RECORD

Cased _____ in., _____ ft.

Sand _____

Gas _____

Oil _____

Total Depth _____

PRODUCTION

1st 24 hrs. Nat. _____

1st 24 hrs. after shot _____

Gas _____ Cu. Ft.

Dry Hole _____

Abandoned _____

Date

NOV 13 1925

CHAS. L. SHERWOOD

Butter Co

1410 Map No. **KANSAS** Sec. 27 Twp. 27 R. 7

Well No. *2 Med Sub*
Phillips Pet Co Company

Contractor

COMPLETED

SECTION PLAT

----- Ft. from N. Line

250

----- Ft. from S. Line

----- Ft. from E. Line

250

----- Ft. from W. Line

0			

Location -----

Rig up -----

Drilling and Remarks:

Handy Sub 2708-2721'
Oil 2721-2753'

100 100 bhs.

RECORD

Cased ----- in., ----- ft.

Sand *2721-2753'*

Gas -----

Oil -----

Total Depth *2754 m sub*

PRODUCTION

1st 24 hrs. Nat. -----

1st 24 hrs. after shot -----

Gas ----- Cu. Ft.

Dry Hole -----

Abandoned -----

Date

JAN 20 1926

CHAS. L. SHERWOOD
192 Scout