FORM 51 10M 8-47

KANSAS Barton


Section 34 Township 18 Range 15W

Well No. #1 Glessner

Company N. Appleman

Albert

15

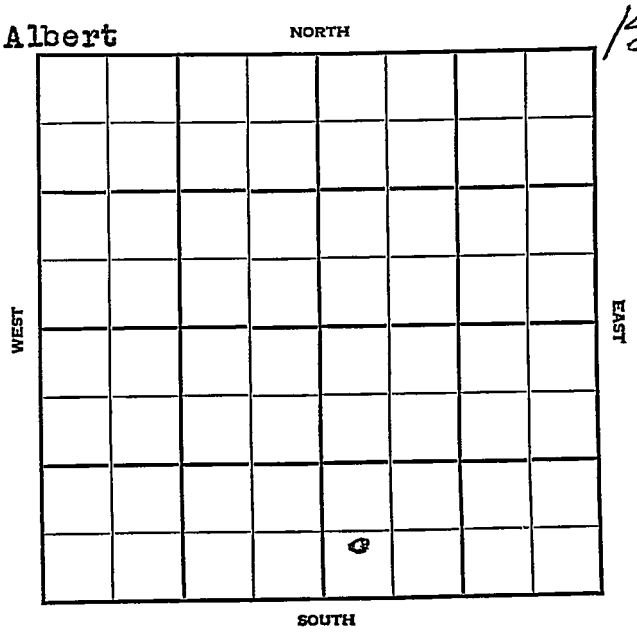


FORM 252-A
5M 9-47 PETROL

Barton

KANSAS

Sec. 34 Twp. 18 R. 15W

Well No. #1 Glessner Farm
N. Appleman
Albert Company

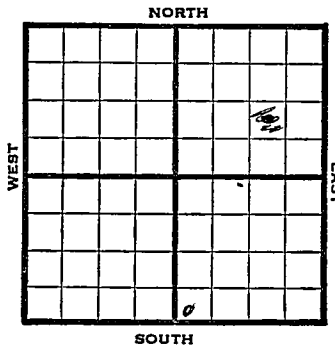

_____ Ft. from N. Line

430 Ft. from S. Line

_____ Ft. from E. Line

330 Ft. from W. Line

SW SE

1947	Elev. 1944' REPORT
10/22	8" @ 924' 2745'
10/29	Basal 3529' Drlg. 3553'
11/5	Lansing 3235' BKC 3466' Conglomerate 3482' Gorham 3513' TD 3560' 5" @ 3553' RUST
11/12	TD 3560' 10 qts. Swab 4 bbls. oil PH 2 hrs.
11/19	"
11/25	"
12/3	"
12/10	"
12/17	"
12/30	"
1948 1/7	"

OVER

Form 26 200 Bks. 10-46 Petrol

Kansas Albert

Map No. _____ Sec. 34 Twp. 18 R. 15W

Well No. 1 Glessner

N. Appleman Company

FIRST REPORT Contractor

SW SE


SECTION PLAT

_____ Ft. from N. Line

430 Ft. from S. Line

_____ Ft. from E. Line

330 Ft. from W. Line

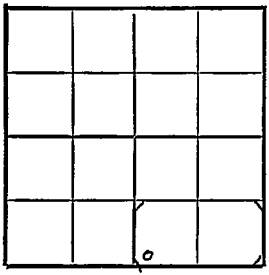

Barton County

Location _____

Rig up _____

Drilling and Remarks:

8"@ 924'

2745'

RECORD

Cased _____ in., _____ ft.

Sand _____

Gas _____

Oil _____

Total Depth _____

PRODUCTION

1st 24 hrs. Nat. _____

1st 24 hrs. after shot _____

Gas _____ Cu. Ft.

Dry Hole _____

Abandoned _____

Date

OCT 2 2 1947 19 S. J. LEWIS Scout

Form 26 200 Bks. 10-46 Petrol

Albert Pool

Kansas

Map No. 73 Sec. 34 Twp. 18 R. 15W

Well No. 1 Glessner


N. Appleman Company

COMPLETE Contractor

SW SE

E 1, 1944

SECTION PLAT

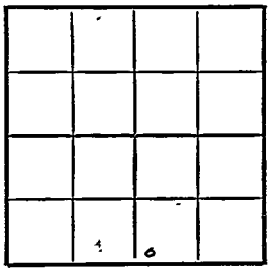

____ Ft. from N. Line

430 Ft. from S. Line

____ Ft. from E. Line

330 Ft. from W. Line

Barton County

Location

Rig up

Drilling and Remarks:

Base 3529

5" @ 3553

Pump 60 BO,

36 G/Hr

RECORD

Cased ____ in., ____ ft.

Sand

Gas

Oil ✓

Total Depth 3560

PRODUCTION

1st 24 hrs. Nat.

1st 24 hrs. after shot

Gas ____ Cu. Ft.

Dry Hole

Abandoned

Date

JAN 14 1948 19

S. J. LEWIS Scout

1948

1/14 Basal 3529'
5" @ 3553'
Pump 35 Pot
36.0 Gr.
TD 3560'
Comp.

COMPLETED