

FORM 51

Barton

KANSAS

Section 35

Township 18

Range 15W

Well No. 1

Barr

(Bahr)

Company Lee Phillips

NORTH

13

WEST

EAST

	0						

SOUTH

Sec. 35 Twp. 18 R. 15W

Well No. #1 Barr Farm

Lee Phillips Company

Contractor


\_\_\_\_\_ Ft. from N. Line

330 Ft. from S. Line

\_\_\_\_\_ Ft. from E. Line

990 Ft. from W. Line

SE SW SW

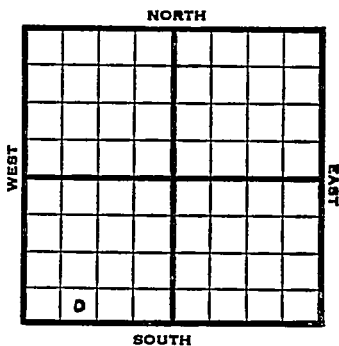

1952 Elev. 1947' REPORT

11/26 Spud 11-24-52  
8" @ 650'  
Drlg. 760'

12/4 Drlg. 2450'

12/11 Heeb 3193 Lans 3274 Reagan Sd 3568  
Dst 3573-80 RTD 1/4 Hr. 55' OCM 200'  
clean oil DST 3569-73 1/4 Hr. 7' M  
5" @

12/17 Spud 11-24-52  
D&A  
TD 3580'  
8" @ 650  
Heeb. 3193, Lans 3274, Regan sd  
3568  
DST 3573-80, opn 1/4 hrs., rec.  
55' ocm, 200' cleanoil  
DST 3569-73, opn 1/4 hrs., rec. 7'  
mud, 5" @ 3573, CO to 3580  
FU 600' oil 150' wtr 16 hrs.  
D&A

**ABANDONED**



