


Section 1 Township 20 Range 10W

Well No. 2 Scott

Company B C Hyde Jr.

Chase Pool
NORTH

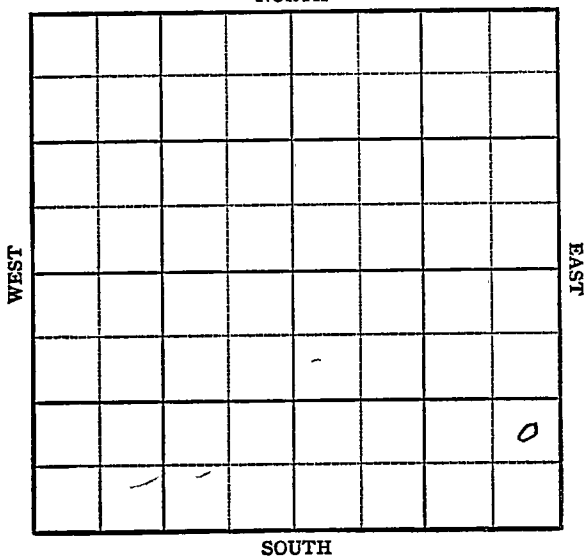

KANSAS Rice



Sec. 1 Twp. 20 R. 10W

Well No. #2 Scott Farm

B. C. Hyde, Jr. Company

Chase Pool


 Ft. from N. Line

990' Ft. from S. Line

330' Ft. from E. Line

 Ft. from W. Line

NE SE SE

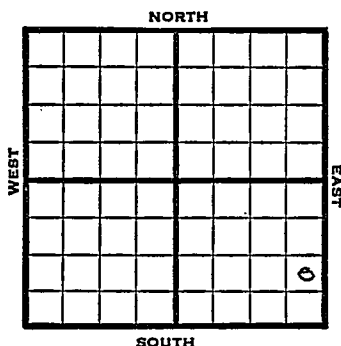

1948 Elev. 1740' REPORT

10/27 8" @ 185'
Drlg. 2615'
11/3 Simpson 3277'
Arb. 3283-86'
TD 3286'
5"@ 3277'
11/10 "
11/16 "
11/23 "
11/30 "
12/6 "
12/14 950' oil 15 hrs.
12/22 "
12/29 "
1949
1/5 Arb 3285'
5"@ 3277'
Pump 30 oil Pot.
Gr. 42°
TD 3286'

COMPLETED

Map No. _____ Sec. 1 Twp. 20 R. 10W

Well No. 2 Scott

B. C. Hyde Jr. Company

FIRST REPORT

Contractor

NE SE SE

SECTION PLAT

_____ Ft. from N. Line

990 Ft. from S. Line

330 Ft. from E. Line

_____ Ft. from W. Line

			o

Rice County, E

Location _____

Rig up _____

Drilling and Remarks:

8" @ 185

drlg. 2615

RECORD

Cased _____ in., _____ ft.

Sand _____

Gas _____

Oil _____

Total Depth _____

PRODUCTION

1st 24 hrs. Nat. _____

1st 24 hrs. after shot _____

Gas _____ Cu. Ft.

Dry Hole _____

Abandoned _____

Date

OCT 27 1948

19

S. J. LEWIS

Scout

Kansas

Map No. 46 Sec. 1 Twp. 20 R. 10WWell No. 2 Scott


B. C. Hude, Jr.

Company

COMPLETE

Contractor

NE SE SE

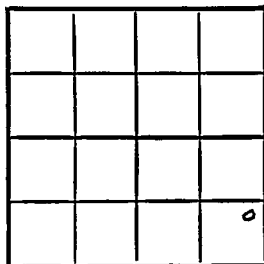E11740
SECTION PLAT Ft. from N. Line990 Ft. from S. Line330 Ft. from E. Line Ft. from W. Line

Rice County

Location Rig up

Drilling and Remarks:

*Cut 3288-**5" 3277**Run 3000 ft**42.0 ft*

RECORD

Cased in., ft.Sand Gas Oil Total Depth 3288

PRODUCTION

1st 24 hrs. Nat. 1st 24 hrs. after shot Gas Cu. Ft.Dry Hole Abandoned

Date

JAN 5 1949

19

S. J. LEWIS

Scout