

KANSAS


Barton


Form 51-5M-7-40-Palace

Section 35 Township 18 Range 15-W

Well No. #1 Bahr "B"

Company Clay Bros.

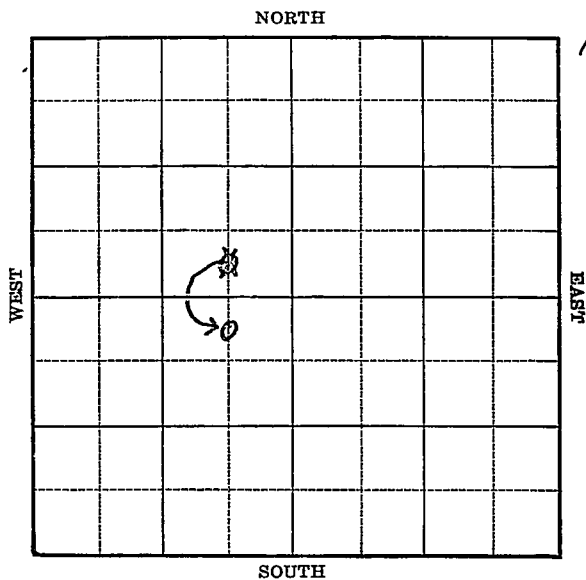

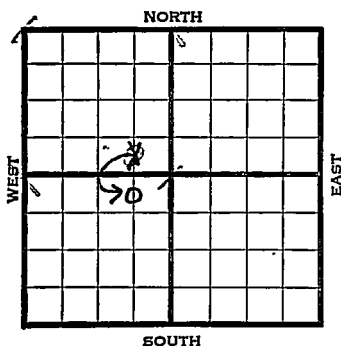

1941	REPORT
2/12	Derrick.
2/20	Surface hole.
2/27	Drlg. 890'
3/6	13" - 119' 8" - 910'
	Drlg. 1985'
3/13	Drlg. 3400'
3/20	Lans. 3210' Cong. 3465'
	Reagan 3488-90' T.D.
	5" - 3484' RUST.
3/27	T.D. 3540' SO & G.
4/2	T.D. 3544' Shot 70 qts. 3489 to
	3516' C. O.
4/10	" " "
4/18	" " "
4/24	" " "
5/1	" " "
	OVER

1941

5/7

Reagan 3488'

5" - 3484'

T.D. 3547'

Shot 70 qts. 3489-3516'

1 $\frac{1}{2}$ M gas.

COMPLETED

Map No. 73 Sec. 35 Twp. 18 R. 15WWell No. 1 BahrClay Bros.


Company

FIRST REPORT

Contractor

SECTION PLAT

C S L SE NW

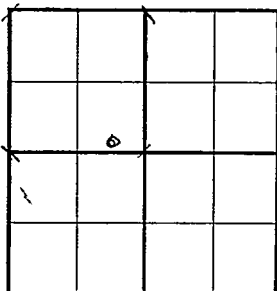 Ft. from N. Line330 Ft. from S. Line660 Ft. from E. Line Ft. from W. Line

ALBERT POOL

Location Rig up

Drilling and Remarks:

Derrick

RECORDCased in., ft.Sand Gas Oil Total Depth **PRODUCTION**1st 24 hrs.-Nat. 1st 24 hrs. after shot Gas Cu. Ft.Dry Hole Abandoned

Date

FEB 12 1941 19

S. J. LEWIS Scout

Map No. 73 Sec. 35 Twp. 18 R. 15WWell No. 1 Bahr "B"

Clay Bros.

Company

CORRECTION

Contractor

C N L NE SW

330 Ft. from N. Line Ft. from S. Line660 Ft. from E. Line Ft. from W. Line

ALBERT POOL

SECTION PLAT

	o		

Location Rig up

Drilling and Remarks:

Reported as

#1 Bahr

C S L SE NW

RECORD

Cased in., ft.Sand Gas Oil Total Depth

PRODUCTION

1st 24 hrs. Nat. 1st 24 hrs. after shot Gas Cu. Ft.Dry Hole Abandoned

Date

FEB 26 1941 19

S. J. LEWIS Scout

Map No. 73 Sec. 35 Twp. 18 R. 15WWell No. 1 Bahr "B"Clay Bros. CompanyCOMPLETED Contractor

C N L NE SW

330 Ft. from N. Line Ft. from S. Line660 Ft. from E. Line Ft. from W. Line

ALBERT POOL

SECTION PLAT

	o		

Location Rig up

Drilling and Remarks:

*Reagan 3488.**5" 3484**709 to 3489-3516**1 1/2 M Gas.*

RECORD

Cased in., ft.Sand Gas Oil Total Depth 3547

PRODUCTION

1st 24 hrs. Nat. 1st 24 hrs. after shot Gas Cu. Ft.Dry Hole Abandoned

Date

MAY 7 1941 19 S. J. LEWIS Scout