

Section 1 Township 20 Range 10WWell No. #2 McFarlandCompany Rockett Drlg.

NORTH

							0

WEST

EAST

SOUTH

Rice

KANSAS

Sec. 1 Twp. 20 R. 10WWell No. #2 McFarland Farm

Rockett Drlg. Company

Rockett Contractor

Chase


330 Ft. from N. Line

Ft. from S. Line

330 Ft. from E. Line

Ft. from W. Line

NE NE SE

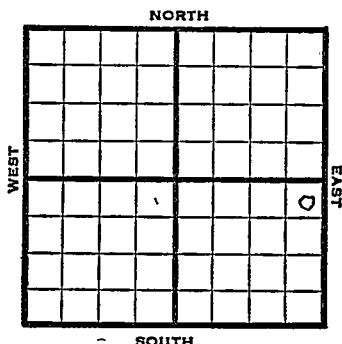

1952 Elev. 1738' REPORT

1/30 Location

2/6 8" @ 218
Anhy 376
Drlg. 2585'2/13 Heeb 2794' Br Li 2926' Lans 2954'
DST 3032-47, 1 hr, 60' M
Simp shale 3256' Simp sd 3267'
Arb. 3271 5" @ ?2/20 RTD 3510 4" @ 3336'
CO to 3285 20/ 3277-79
Est. 2 gal oil ph 200 A

3/5 NR

3/12 Spud 1-31-52
Oil Well TD 3510
8" @ 218 Anhy 376
Heeb. 2794 Br Lime 2926
Lans. 2954
DST 3032-47 opn 1 hr. Rec. 60' mud
Simp sh 3256 Simp sd 3267
Arb. 3277 4" @ 3336
TD 3510 CO to 3285 20/3277-79
2 goph 200 A Comp 50 bopd

COMPLETION

County Rice State KansasSec. 1 (Blk. Twp.) 20 (Sur. Rge.) 10W Map No.Operator Rockett Drlg.Well No. 2 Farm McFarlandElev. Location NE NE SE

FIRST REPORT

0

330 Ft. From N Line SE330 Ft. From E Line Quarter

1st. Report JAN 30 1952

Completion

Remarks

Rockett - Contr.

Spudding Date

Drlg. Data ChaseLocation


J. G. McGEHEE

County Rice State
 Sec. 1 (Blk.) 20 (Sur.) 10W Map No.
 (Twp.) (Rge.)

Operator Rockett Drlg.

Well No. 2 Farm McFarland

Elev. 1738 Location NE NE SE

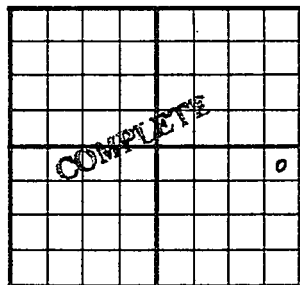

330 Ft. From N Line SE

330 Ft. From E Line Quarter

1st. Report

Completion MAR 1 2 1952

Remarks Chase Pool

Rockett - Contr.

Spudding Date 1-31-52

Drlg. Data Oil well TD 3510

8" @ 218 Anhy 376 Heeb. 2794

Br. lime 2926 Lans. 2954 DST 3032-47

open 1 hr. Rec. 60' mud Simp. sh. 3256

Simp. sd. 3267 Arb. 3277 4" @ 3336

TD 3510 CO to 3285 20/ 3277-79

2 goph 200 A Comp. 50 bopd