


Section 35 Township 18 Range 15W

Well No. #1, McKay

Company Hannum Drlg.

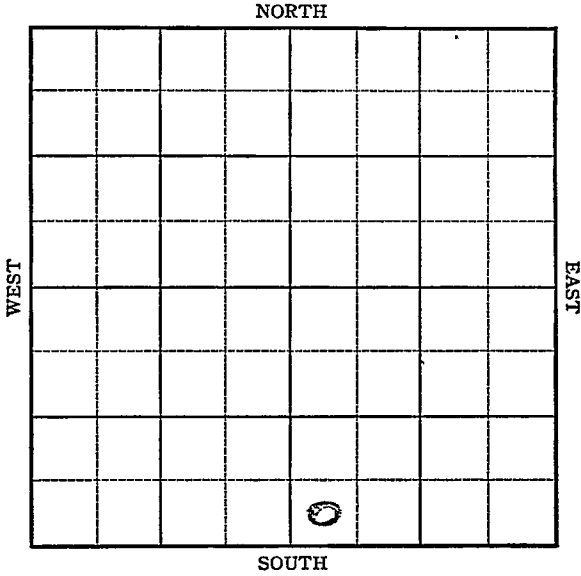

KANSAS Barton County

Sec. 35 Twp. 18 R. 15W

Well No. #1 McKay Farm

Hannum Drlg Company


Mertens

Ft. from N. Line

330 Ft. from S. Line

Ft. from E. Line

330 Ft. from W. Line

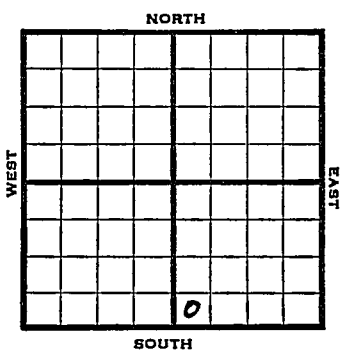

SW SE

1946 Elev. 1883 REPORT

- 5/29 Anhy 950  
8" @ 962' WOC
- 6/5 Drlg. 2700
- 6/12 Regan 3560  
TD 3563'  
5" @ 3561 RUST
- 6/18 TD 3572'
- 6/26 Reagan 3560  
5" @ 3561  
TD 3572  
Pump 50 Pot.  
Grav. 36.0

COMPLETED

**KANSAS** Kansas Pool Name Mertens  
 Map No. 73 Sec. 35 Twp. 18 R. 15W  
 Well No. 1 McKay

Hannum Drlg. Company

**FIRST REPORT** Contractor

SW SE

**SECTION PLAT**

\_\_\_\_\_ Ft. from N. Line  
330 Ft. from S. Line  
 \_\_\_\_\_ Ft. from E. Line  
330 Ft. from W. Line


Barton County

Location \_\_\_\_\_

Rig up \_\_\_\_\_

Drilling and Remarks:

Anhy 950  
 8" @ 962 WOC

**RECORD**

Cased \_\_\_\_\_ in., \_\_\_\_\_ ft.  
 Sand \_\_\_\_\_  
 Gas \_\_\_\_\_  
 Oil \_\_\_\_\_  
 Total Depth \_\_\_\_\_

**PRODUCTION**

1st 24 hrs. Nat. \_\_\_\_\_  
 1st 24 hrs. after shot \_\_\_\_\_  
 Gas \_\_\_\_\_ Cu. Ft.  
 Dry Hole \_\_\_\_\_  
 Abandoned \_\_\_\_\_

Date

MAY 29 1946 19

S. J. LEWIS Scout

KANSAS Kansas Pool Name Mertens Pool  
 Map No. 73 Sec. 35 Twp. 18 R. 15W

Well No. 1 McKay

Hannum Drlg. Company

**COMPLETED**

Contractor

SW SE

*E1, 1883*  
SECTION PLAT

\_\_\_\_\_ Ft. from N. Line

330 Ft. from S. Line

\_\_\_\_\_ Ft. from E. Line

330 Ft. from W. Line


Barton County

Location \_\_\_\_\_

Rig up \_\_\_\_\_

Drilling and Remarks:

*Reagan 3560*  
*5" 3561*  
*Pump 50 Pst*

*360 Gr*

**RECORD**

Cased \_\_\_\_\_ in., \_\_\_\_\_ ft.

Sand \_\_\_\_\_

Gas \_\_\_\_\_

Oil \_\_\_\_\_

Total Depth 352

**PRODUCTION**

1st 24 hrs. Nat. \_\_\_\_\_

1st 24 hrs. after shot \_\_\_\_\_

Gas \_\_\_\_\_ Cu. Ft.

Dry Hole 111 1/2

Abandoned \_\_\_\_\_

Date

JUN 26 1946 19

*4144*  
**S. J. LEWIS** Scout