

O.W.W.O.

Barton

FORM 51 5M PETROL

KANSAS

Section 36 Township 18- Range 15-W

Well No. #7 Howell

Company Vickers Killison Drilling

NORTH

WEST

EAST

								o	

SOUTH

KANSAS

Barton County ✓

Sec. 36 Twp. 18 R. 15W

Well No. #1 Howell Farm _____

Vickers Company _____

Mertens


990 Ft. from N. Line

_____ Ft. from S. Line

330 Ft. from E. Line

_____ Ft. from W. Line

SE NE SE

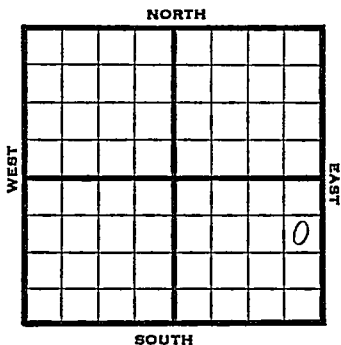

1946 Elev. 1893 REPORT

3/6	Anhy. 875	
	8" @ 882'	
	1200'	3512
3/14	Drlg. 3280'	<u>1893</u>
		1619

3/20	Lans 3211
	BKC 3452
	Arb. 3512
	TD 3531'

ABANDONED

KANSAS Kansas Pool Name Mertens

Map No. 22 Sec. 36 Twp. 18 R. 15W

Well No. 1 Howell

Vickers Company

~~FIRST REPORT~~ Contractor

SE NE SE


SECTION PLAT

990 Ft. from N. Line

_____ Ft. from S. Line

330 Ft. from E. Line

_____ Ft. from W. Line

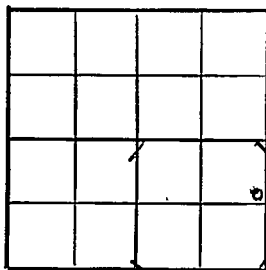

Barton County

RECORD

Location _____

Cased _____ in., _____ ft.

Rig up _____

Sand _____

Drilling and Remarks:

Gas _____

anhy 875

Oil _____

8"-882

Total Depth _____

1200'

PRODUCTION

1st 24 hrs. Nat. _____

1st 24 hrs. after shot _____

Gas _____ Cu. Ft.

Dry Hole _____

Abandoned _____

Date

MAR 6 1946 19

S. J. LEWIS Scout

KANSAS

Kansas Pool Name Mertens

Map No. 73 Sec. 36 Twp. 18 R. 15W

Well No. 1 Howell

Vickers Company

ABANDONED

Contractor

E. I. 1893

SE NE SE

SECTION PLAT

990 Ft. from N. Line

_____ Ft. from S. Line

330 Ft. from E. Line

_____ Ft. from W. Line

Barton County

Location _____

Rig up _____

Drilling and Remarks:

Lane 3211

BKC 3452

CEJ 3512

RECORD

Cased _____ in., _____ ft.

Sand _____

Gas _____

Oil _____

Total Depth 2531

PRODUCTION

1st 24 hrs. Nat. _____

1st 24 hrs. after shot _____

Gas _____ Cu. Ft.

Dry Hole _____

Abandoned _____

Date

MAR 20 1946 19

S. J. LEWIS Scout

Twp. X Pool X

Co. X Facets 3

O.W.W.O.

S-513-B

County Barton Elev. 1893 DF
 Sec. 36 Twp. 18 Rge. 15W
 Company Wilkinson Drlg.
 Farm Name Howell No. 6

TOPS	DEPTH	LOG	DATUM
Anh.			
Tp.			
H.			
Tr.			
Dg.			
B.L.			
L. <u>KC</u>	<u>3218</u>		
K.C.			
B.K.C.			
Ce.			
C.			
M.			
M.			
K.			
Mz.			
Mq.			
V.			
S.			
S.			
A.	<u>3512</u>		
R.			
Pf.			
G.			
T.D.			

Loc. in Sec. SE NE SE
O.W.W.O.
 Geol. O.W.W.O.
 Contr. Wilkinson #2
 Pool Merten

FIRST REPORT
 MAR 26 1958

Date Comm. _____

OLD INFO: tops. D&A 3/13/46.
NEW INFO: 8" @ 882, MTR co 3531 OTD, DD
3686 TD Granite 3683, 5" @ 3584 w/100 ? MICT
CO to 3686 TD, Tstg. (Pred. Arb. - SWD in
L. Arb.

Co.
Lse.
No.
Sec.
T.
R.

~~Twp Pool~~

O.W.W.O.

~~Foot~~

5-513-B

Co.

Sec.

No.

Sec.

T

R.

County Barton Elev. 1893 DF
 Sec. 36 Twp. 18 Rge. 15W
 Company Wilkinson Dalg.
 Farm Name Howell No. 6

TOPS	DEPTH	LOG	DATUM
Anh.			
Ip.			
H.			
Tr.			
Dg.			
B.L.			
L. <u>KC</u>	<u>3218</u>		
K.C.			
B.K.C.			
Ce.			
C.			
M.			
M.			
K.			
Mz.			
Mq.			
V.			
S.			
S.			
A.	<u>3512</u>		
R.			
Pf.			
G.			
T.D.			

Loc. in Sec. S7 W7 S7
O.W.W.O.
 Geol. Wilkinson #2
 Contn. Wilkinson #2
 Pool. Kerten NE

ABANDONED
 AUG 20 '58

Dater Comm. 3/13/46
 OLD INFO: 8" @ 882, M.R. co 3531 O.T.D., DD
3686 TD Granite 3' 83, 5" @ 3581, w 100 ? NTOT
CO to 3686 TD Test (Prod. Arb. 2' SWD in
Arb. CO 3686 TD @ 38
B w ph A input 120 BW ph
dispose in Arbuttle PB
3570 24/3525-31 @ 590 ph NW
nt 250A @ 34 BW ph mount
750A @ 280 ph 6 hrs NW

FORM 513-1 SUNRAY

APR 9 '58 APR 16 '58 APR 23 '58 APR 30 '58 MAY 7 '58
MAY 14 '58 MAY 21 '58 MAY 28 '58 JUN 3 '58 JUN 11 '58

JUN 18 '58 JUN 25 '58 JUL 2 '58 Prod PKV

3575 JUL 9 '58 JUL 16 '58 JUL 23 '58 JUL 30 '58

AUG 6 '58 AUG 13 '58 AUG 20 '58 PAY P 56.30

pd NW av 38.5

adv 3525-31

SW Durian granite

36-18-15W

se ne se