


Map No. KANSAS Sec. 24 Twp. 31 R. 2E
Well No. 4-Shore Farm _____
Tom Johnson, Vickers Company

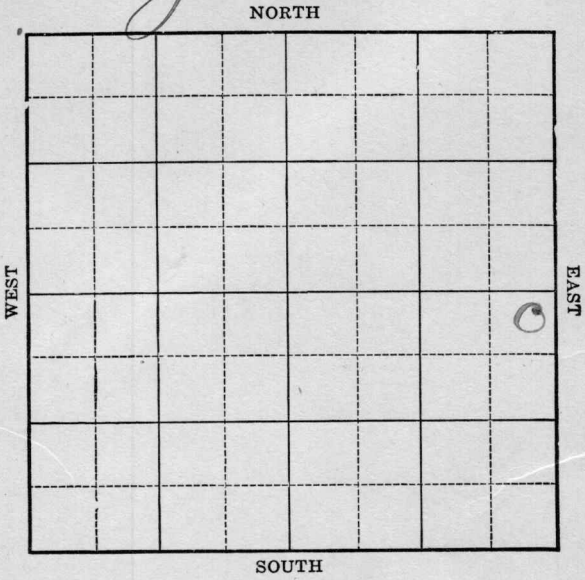

Location _____
Drilling Remarks _____

Rig Up _____
Drilling Remarks _____

RECORD

PRODUCTION

Cased _____ in. _____ ft.
Sand _____
Gas _____
Oil _____
Total Depth _____

1st 24 hrs. Nat. _____
1st 24 hrs. after shot _____
Gas _____ cu. ft.
Dry Hole _____
Abandoned _____

Map No. KANSAS Sec. 24 Twp. 31 R. 2E

Well No. 4 - Shore Farm


Tom Johnson & Vickers Company

220 Ft. from N. Line

_____ Ft. from S. Line

320 Ft. from E. Line

_____ Ft. from W. Line

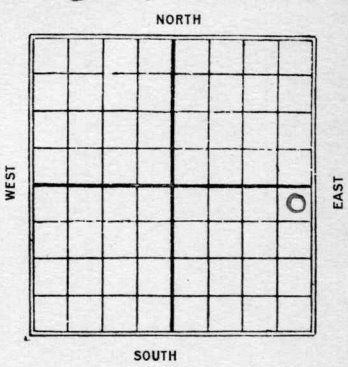

1927

Date	REPORT
11/23	Rig Bldg.
11/29	Rig
12/7	—
12/14	—
12/21	—
12/28	—
1928	
1/4	Drly 410'
1/11	" 800
1/18	T.D. 1140-u.R. 10"
1/25	Drly 1700
1/31	Sand 1907-83-dry-S.D.
2/15	Drilling 2003-hole full water
2/22	D. & A. 2003

Map No. **KANSAS** Sec. 24 Twp. 31 R. 2E

Well No. 4 Shore

Tom Johnson & Vickers Company

Contractor

SECTION PLAT

			o

220 Ft. from N. Line

----- Ft. from S. Line

220 Ft. from E. Line

----- Ft. from W. Line

FIRST REPORTS

Location -----

Rig up -----

Drilling and Remarks:

Rig Bldg

RECORD

Cased ----- in., ----- ft.

Sand -----

Gas -----

Oil -----

Total Depth -----

PRODUCTION

1st 24 hrs. Nat. -----

1st 24 hrs. after shot -----

Gas ----- Cu. Ft.

Dry Hole -----

Abandoned -----

Date

NOV 23 1927

192

S. J. LEWIS

Scout

Map No. **KANSAS** Sec. 24 Twp. 31 R. 26

Well No. 4 Shores

Tom Johnson & Vickers Company

Contractor

SECTION PLAT

220 Ft. from N. Line

----- Ft. from S. Line

220 Ft. from E. Line

----- Ft. from W. Line

			o

ABANDONED

Location -----

Rig up -----

Drilling and Remarks:

TW 2003

JVA

RECORD

Cased ----- in., ----- ft.

Sand -----

Gas -----

Oil -----

Total Depth -----

PRODUCTION

1st 24 hrs. Nat. -----

1st 24 hrs. after shot -----

Gas ----- Cu. Ft.

Dry Hole -----

Abandoned -----

Date

FEB 22 1928

S. J. LEWIS

192

Scout

Summer

MAP NO. K1 KANSAS SEC. 24 TWP. 31S R. 2E

WELL NO. 4 Shaw

Unkers COMPANY

CONTRACTOR

SECTION PLAT

_____ FT. FROM N. LINE

_____ FT. FROM S. LINE

_____ FT. FROM E. LINE

_____ FT. FROM W. LINE

RECORD

LOCATION _____

CASED _____ IN., _____ FT.

RIG UP _____

SAND _____

DRILLING AND REMARKS:

GAS _____

OIL _____

TOTAL DEPTH 2870

*We shall
2003
not change*

PRODUCTION

1ST 24 HRS. NAT. _____

1ST 24 HRS. AFTER SHOT _____

GAS _____ Cu. Ft.

DRY HOLE

ABANDONED

DATE

3/28 192 8

SCOUT