

KANSAS

Rice

Section 1 Township 20 Range 10WWell No. 3 MaloneCompany Pickrell & Ramsey

Silica

NORTH

							0

WEST

EAST

SOUTH

Rice KANSAS
20

✓
LOW

Sec. 1 Twp. _____ R. _____

Well No. #3 Malone Farm _____

Pickrell & Ramsey Company _____

Silica Pool


_____ Ft. from N. Line

330' Ft. from S. Line

330' Ft. from E. Line

_____ Ft. from W. Line

SE NE

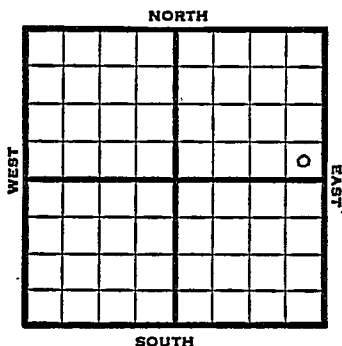

1949 Elev 1736' REPORT

9/7 Surface Hole
9/14 8" @ 203'
Simpson 3267-68'
TD 3268'
5" @ 3268'

9/21 "
9/28 TD 3274'
Arb. 3273'
5" @ 3268'
Simp 3267'
PB 3272'
Pump 25 Oil Pot
44° Gr.
Comp

COMPLETED

Map No. _____ Sec. 1 Twp. 20 R. 10W

Well No. 3 Malone

Pickrell & Ramsey Company

Contractor

SE NE

**FIRST REPORT
SECTION FLAT**

Ft. from N. Line

330 Ft. from S. Line

330 Ft. from E. Line

Ft. from W. Line

			0

Rice County

Location _____

Rig up _____

Drilling and Remarks:

surface hole

RECORD

Cased _____ in., _____ ft.

Sand _____

Gas _____

Oil _____

Total Depth _____

PRODUCTION

1st 24 hrs. Nat. _____

1st 24 hrs. after shot _____

Gas _____ Cu. Ft.

Dry Hole _____

Abandoned _____

Date

SEP 7 1949 19

S. J. LEWIS Scout


Kansas

Map No. _____ Sec. 1 Twp. 20 R. 10WWell No. 3 MalonePickrell & Ramsey Company

COMPLETE

Contractor

SE NE

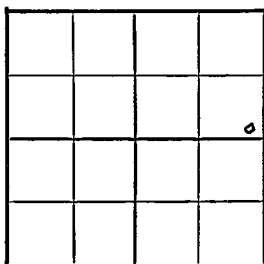E 11786
SECTION PLAT

_____ Ft. from N. Line

330 Ft. from S. Line330 Ft. from E. Line

_____ Ft. from W. Line

Rice County

Location _____

Rig up _____

Drilling and Remarks:

Cor. 32725' 03268Imp. 32623272.Imp. 2521144 2/3

RECORD

Cased _____ in., _____ ft.

Sand _____

Gas _____

Oil _____

Total Depth 3274

PRODUCTION

1st 24 hrs. Nat. _____

1st 24 hrs. after shot _____

Gas _____ Cu. Ft.

Dry Hole _____

Abandoned _____

Date

SEP 28 1949

19

S. J. LEWIS

Scout