

KANSAS

Barton

Section 35 Township 18 Range 15-WWell No. #1 in cKayCompany Phil-Han

NORTH

16

							0

SOUTH

WEST

EAST

KANSAS

Barton County

Sec. 35 Twp. 18 R. 15W

Well No. #1 McKay Farm

Phil-Han Company

Mertens


 Ft. from N. Line

330 Ft. from S. Line

330 Ft. from E. Line

 Ft. from W. Line

SE/c

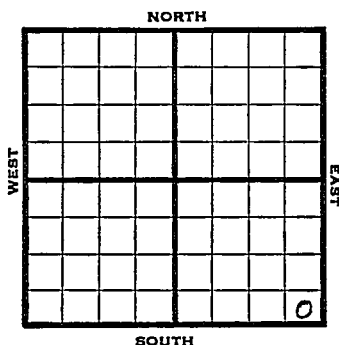

1946

Elev. 1953

REPORT

1/9

8" @ 954
Drlg. 1955'

1/17

Anhy 930'
Drlg. 3339'

1/24

Lans. 3276' Cong. 3527'
Arb. 3553' T.D. 3557' 5" - 3554'
RUST.

1/30

Arb. 3553
5" @ 3554
500 acid.
TD 3577' wtr.

ABANDONED

KANSAS

Kansas Pool Name MertensMap No. 73 Sec. 35 Twp. 18 R. 15WWell No. 1 McKayPhil-Han


Company

FIRST REPORT

Contractor

SE/c

SECTION PLAT

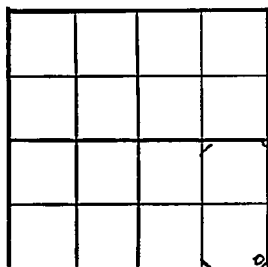 Ft. from N. Line330 Ft. from S. Line330 Ft. from E. Line Ft. from W. Line

Barton County

Location Rig up

Drilling and Remarks:

8"-954

1955

RECORD

Cased in., ft.Sand Gas Oil Total Depth

PRODUCTION

1st 24 hrs. Nat. 1st 24 hrs. after shot Gas Cu. Ft.Dry Hole Abandoned

Date

JAN 9 1946 19

S. J. LEWIS

Scout

KANSAS Pool Name Mertens
 Map No. 23 Sec. 35 Twp. 18 R. 15W

Well No. 1 McKay

Phil-Han


Company

ABANDONED

Contractor

SE/c

E. 1, 1953
SECTION PLAT

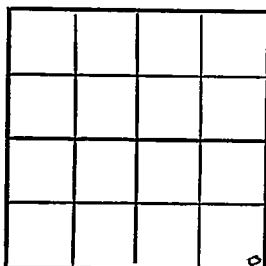

 Ft. from N. Line

330 Ft. from S. Line

330 Ft. from E. Line

 Ft. from W. Line

Barton County

Location

Rig up

Drilling and Remarks:

Cor 23583
5" C 23584
500 Bcu
Water

RECORD

Cased in., ft.

Sand

Gas

Oil

Total Depth 2522

PRODUCTION

1st 24 hrs. Nat.

1st 24 hrs. after shot

Gas Cu. Ft.

Dry Hole

Abandoned

Date

JAN 30 1946 19

S. J. LEWIS

Scout