

KANSAS


Barton

FORM 51 5M PETROL

Section 36 Township 18 Range 15-W

Well No. #1 Howell

Company Virginia Brlg

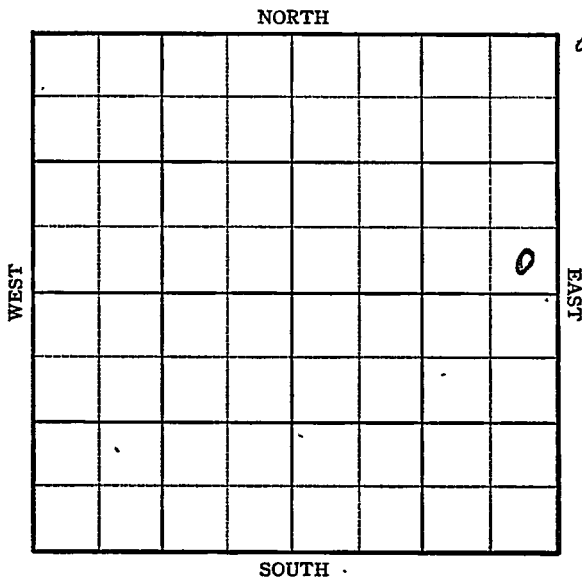

Sec. 36 Twp. 18 R. 15W

Well No. #1 Howell Farm

Virginia Drlg. Company


Mertens

_____ Ft. from N. Line

330 Ft. from S. Line

330 Ft. from E. Line

_____ Ft. from W. Line

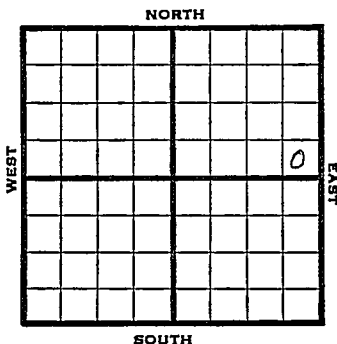

SE NE

1945 Elev. 1895' REPORT

12/28 Location 3494
 1946 1895
 1/10 8" - 890' Anhy 882' 1599
 WOC.

1/17 Drlg. 2287'

1/24 Lans. 3227' Cong. 3459'
 Drlg. 3472'

1/31 Arb. 3494-96' T.D. SSO
 5" - 3494' RUST.

2/7 T.D. 3502' 1200' oil 12 hours.

2/13 Arb. 3494
 5" @ 3494
 TD 3502'
 Pump 100 Pot.
 Grav. 35

COMPLETED

KANSAS Kansas Pool Name Mertens

Map No. 11-73 Sec. 36 Twp. 18 R. 15W

Well No. 1 well

Virginia Drlg. Company

FIRST REPORT Contractor

SE 1/4

SECTION PLAT

 Ft. from N. Line

330 Ft. from S. Line

330 Ft. from E. Line

 Ft. from W. Line

Barton County

Location X

Rig up

Drilling and Remarks:

RECORD

Cased in., ft.

Sand

Gas

Oil

Total Depth

PRODUCTION

1st 24 hrs. Nat.

1st 24 hrs. after shot

Gas Cu. Ft.

Dry Hole

Abandoned

Date

DEC 28 1945

19

S. J. LEWIS

Scout

KANSAS Kansas Pool Name Mertens

Map No. 73 Sec. 36 Twp. 18 R. 15W

Well No. 1 Howell

Virginia Drlg. Company

COMPLETED

Contractor

E. J. 1895

SE NE

SECTION PLAT

_____ Ft. from N. Line

330 Ft. from S. Line

330 Ft. from E. Line

_____ Ft. from W. Line

Barton County

Location _____

Rig up _____

Drilling and Remarks:

Car 43494
5" C 8494
Pump 100 ft

35 ft

RECORD

Cased _____ in., _____ ft.

Sand _____

Gas _____

Oil _____

Total Depth 3522

PRODUCTION

1st 24 hrs. Nat. _____

1st 24 hrs. after shot _____

Gas _____ Cu. Ft.

Dry Hole _____

Abandoned _____

Date

FEB 13 1946 19

S. J. LEWIS Scout