


Rice

Section 1 Township 20 Range 10W

Well No. #8 Malone

Company Pickrell & Ramsey

NORTH

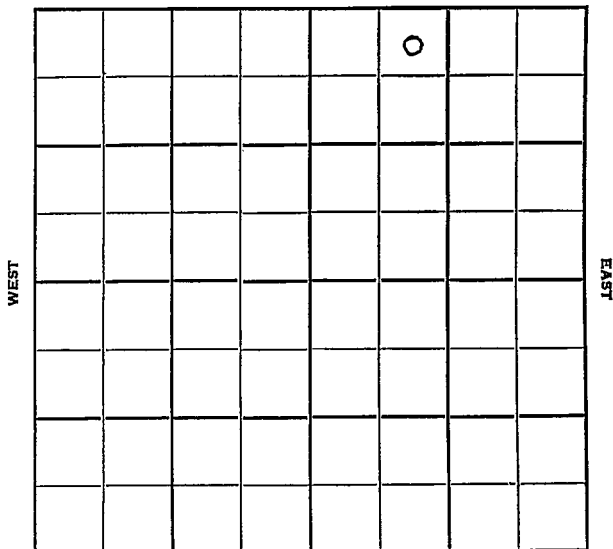

SOUTH

Rice

KANSAS

Sec. 1 Twp. 20 R. 10 W

Well No. # 8 Malone Farm

Pickrell & Ramsey Company

Contractor


**Chase Pool**

330 Ft. from N. Line

Ft. from S. Line

Ft. from E. Line

990 Ft. from W. Line

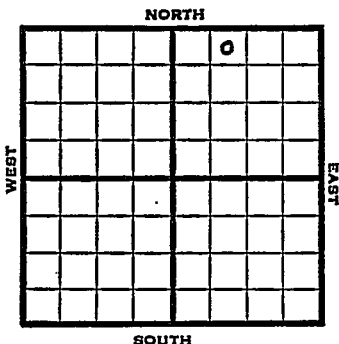

NE NW NE

1951 Elev. 1732' REPORT

2/14 Location

3/14 Spud 2-15-51

Oil well TD 3283

8" @ 195

Heeb. 2801, Br. lime 2928, Lans. 2952

Simp. 3272, Arb. 3278,

TD 3279, 5" @ 3272, DD 3282,

FU 125' oil 1 hr. DD 3283,

FU 2300' oil 12 hr.

Comp. 50 bopd

**COMPLETED**



County Rice State Kansas

Sec. 1 (Blk. 20) (Sur. 10W) (Twp. 10W) Map No.

Operator Pickrell & Ramsey

Well No. 8 Farm Malone

Elev. 1732 Location NE NW NE


330 Ft. From N Line NE

990 Ft. From W Line Quarter

Ist. Report

Completion MAR 14 1951

Remarks Chase Pool

Spudding Date 2-15-51

Drlg. Data Oil well TD 3283

8" @ 195 Heeb. 2801 Br. lime 2928

Lans. 2952 Simp. 3272 Arb. 3278

TD 3279 5" @ 3272 DD 3282 FU 125' oil

1 hr. DD 3283 FU 2300' oil 12 hr.

Comp. 50 bopd

J. E. TYRA