


*Summer*Map No. *KANS* Sec. *24* Twp. *31* R. *2-E*Well No. *2 - Shore* Farm*Johnson & Vickers* Company

NORTH

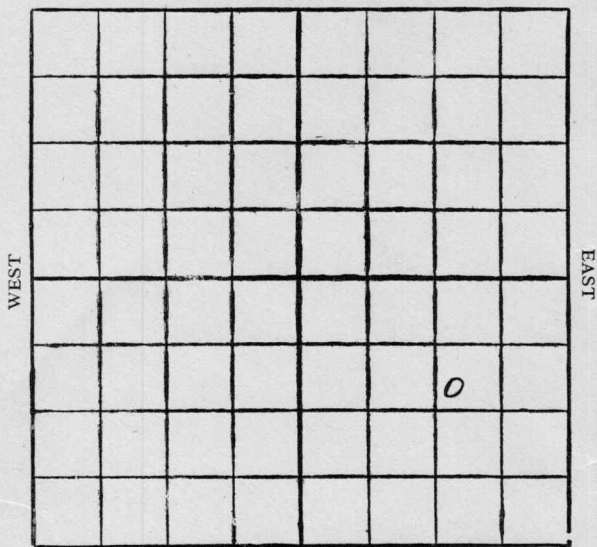

SOUTH

Location

Drilling Remarks

Rig Up.....

Drilling Remarks

RECORD

Cased in. ft.

Sand

Gas

Oil

Total Depth

PRODUCTION

1st 24 hrs. Nat.

1st 24 hrs. after shot


Gas cu. ft.

Dry Hole

Abandoned

Map No. Kans Sec. 24 Twp. 31 R. 2-EWell No. 2 - Shore FarmJohnson & Vickers Company

NORTH

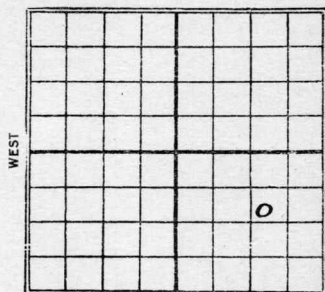1100 Ft. from N. Line

Ft. from S. Line

1100 Ft. from E. Line

Ft. from W. Line

REPORT

~~1927~~
1927

1/26 Rigging up

2/2 same

2/9 Rig

2/16 Spud 210

2/23 Drlg 595

3/2 " 1570

3/9 " 1640

3/16 Top sand 1870'

Oil 1932' - I.D. 1937

shot 18 gts 1919'

to 1936' - swabbed

279 bbls oil & 43

bbls water

Map No. KANSAS Sec. 24 Twp. 31 R. 24

Well No. 2 Slide

Johnson & Vickers Company

Contractor

SECTION PLAT

1100 Ft. from N. Line

_____ Ft. from S. Line

1100 Ft. from E. Line

_____ Ft. from W. Line

			0

FIRST REPORTS

Location _____

Rig up _____

Drilling and Remarks:

Rigging up

RECORD

Cased _____ in., _____ ft.

Sand _____

Gas _____

Oil _____

Total Depth _____

PRODUCTION

1st 24 hrs. Nat. _____

1st 24 hrs. after shot _____

Gas _____ Cu. Ft.

Dry Hole _____

Abandoned _____

Date

JAN 26 1927

S. J. LEWIS

Scout

Map No. KANSAS Sec. 24 Twp. 31 R. 2E

Well No. 2 Shore

Johnson & Vickers Company

Contractor

SECTION PLAT

1100 Ft. from N. Line

_____ Ft. from S. Line

1100 Ft. from E. Line

_____ Ft. from W. Line

COMPLETED

Location _____

Rig up _____

Drilling and Remarks:

TB 1870

Oil 1932

TB 1937

Shot 189 to 1919

& 1936 & watered

27988 hoil 4388h

water 10 hrs

RECORD

Cased _____ in., _____ ft.

Sand _____

Gas _____

Oil _____

Total Depth _____

PRODUCTION

1st 24 hrs. Nat. _____

1st 24 hrs. after shot _____

Gas _____ Cu. Ft.

Dry Hole _____

Abandoned _____

Date

MAR 16 1927

S. J. LEWIS

Scout