Barton

KANSAS

SECTION 36 TOWNSHIP 18S RANGE 15W


WELL NO. #1 Kullman

COMPANY Chief Drlg. & J. A. Terteling

NORTH

SE NE SW

//

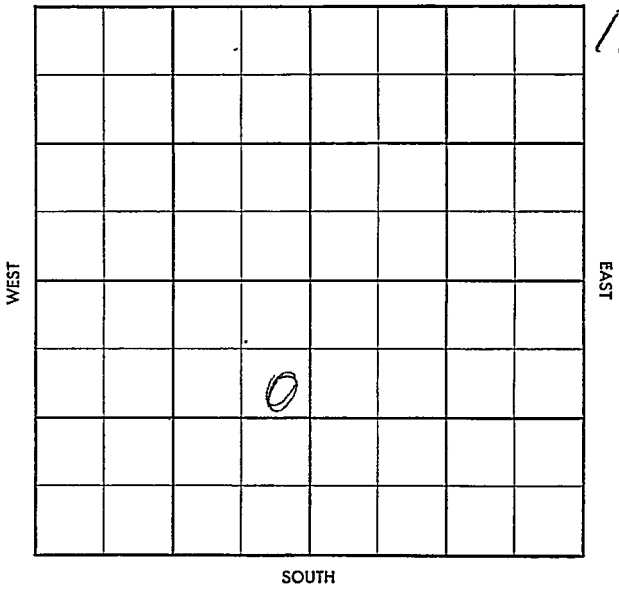

FORM 504-3 SUNRAY

Twp. X Pool X

Rge. X Prod. X

S-513-B

County Barton Elev.

Sec. 36 Twp. 18 Rge. 15W

Company Chief Drlg. and J.A. Terteling

Farm Name Kullman No. 1

TOPS	DEPTH	LOG	DATUM
Anh.			
Tp.			
H.			
Tr.			
Dg.			
B. L.			
L.			
K.C.			
B.K.C.			
Ce.			
C.			
M.			
M.			
K.			
Mz.			
Mq.			
V.			
S.			
S.			
A.			
R.			
Pf.			
G.			
T.D.			

Loc. in Sec. SE NE SW

Geol.

Contr. Chief #1

Pool Merten

APR 9 '58

FIRST REPORT

Date Comm. 4/4/58

8" @ 920 w/450, Drlg. 2650, ETD 3500'

Co. Lse. No. Sec. T. R.

Twp. X Pool X

Sec. X Facet X

S-513-B

County Barton Elev. [illegible]

Sec. 36 Twp. 18 Rge. 15W

Company Chief Drlg. and J.A. Terteling

Farm Name Kullman No. 1

TOPS	DEPTH	LOG	DATUM
Anh.			
Tp.			
H.	3148		
Tr.			
Dg.			
B.L.	3225		
L.	3233		
K.C.			
B.K.C.			
Ce.			
C.	3464		
M.			
M.			
K.			
Mz.			
Mq.			
V.			
S.			
S.			
A.	3516		
R.			
Pf.			
G.			
T.D.	3530		

Loc. in Sec. SE NE SW

Geol.

Contr. Chief #1

Pool Merten

COMPLETE

MAY 21 58

Date Comm. 4/4/58

8" @ 920 w/450, Drlg. 2650, ETD 3500' APR 16 58

DST 3235-45 op 1hr 540' gip 55' oil 70' SW BHP 900/30" DST 3245-68 op 30" 8' M SOC BHP 525/30" DST 3518-30 op 1hr 935' gip 305' gco BHP 1000/30" no log 5" 3520 APR 23 58 to APR 30 58 3530 0250A $380pd NW NT 100' OB DD 3536 (2) $380pd NW NT 100' OB DD 3539 TD FU 1450' oil NW 12hrs $ set 4.8 BPH NW 700' OB TIH

Co. Lse. No. Sec. T. R.

FORM 513-1 SUNRAY

MAY 7 '58 MAY 14 '58 MAY 21 '58 Pot 123 Bopd

NW gr 40°

SE NE SW 30-18-15W