

Rush


FORM 51 5M 2-38 TPCO.

KANSAS

Section 1 Township 18 Range 16-W

Well No. 1 ~~Schlegel~~ Hall Est.

Company Aylward Prod.

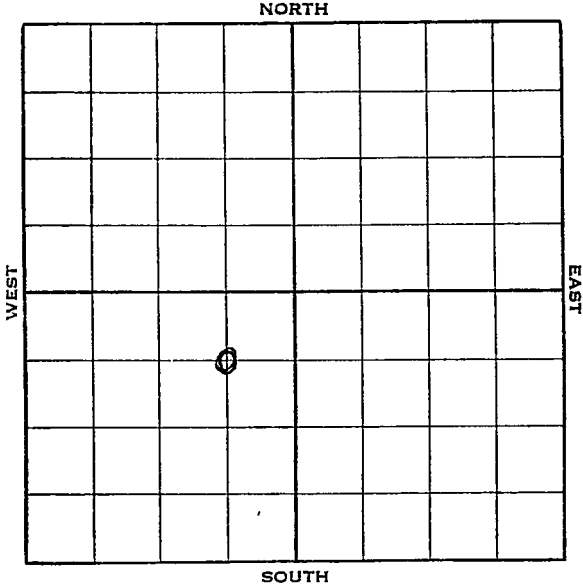



Rush

KANSAS

Map No. 74 Sec. 1 Twp. 18 R. 16WWell No. 1 SchlegelAylward Prod.

Company

Contractor

## FIRST REPORT

## SECTION PLAT

C NE SW

660 Ft. from N. Line

Ft. from S. Line

660 Ft. from E. Line

Ft. from W. Line

	0		

Location \_\_\_\_\_

Rig up \_\_\_\_\_

Drilling and Remarks:

RUR

## RECORD

Cased \_\_\_\_\_ in., \_\_\_\_\_ ft.

Sand \_\_\_\_\_

Gas \_\_\_\_\_

Oil \_\_\_\_\_

Total Depth \_\_\_\_\_

## PRODUCTION

1st 24 hrs. Nat. \_\_\_\_\_

1st 24 hrs. after shot \_\_\_\_\_

Gas \_\_\_\_\_ Cu. Ft.

Dry Hole \_\_\_\_\_

Abandoned \_\_\_\_\_

Date

AUG 10 1938

19

H. D. Hatfield

Scout

Rush KANSAS

Map No. 74 Sec. 1 Twp. 18 R. 16 <sup>W</sup>

Well No. 1-Hall EST.

ageward Prod. Company  
Contractor

C NE SW  
**CORRECTION**

660 Ft. from N. Line

\_\_\_\_\_ Ft. from S. Line

660 Ft. from E. Line

\_\_\_\_\_ Ft. from W. Line  
**CORRECTION**

**SECTION PLAT**

	0		

Location \_\_\_\_\_

Rig up \_\_\_\_\_

Drilling and Remarks:

1st Reported as  
#1 - schlegel  
Change to  
#1 - Hall EST.

**RECORD**

Cased \_\_\_\_\_ in., \_\_\_\_\_ ft.

Sand \_\_\_\_\_

Gas \_\_\_\_\_

Oil \_\_\_\_\_

Total Depth \_\_\_\_\_

**PRODUCTION**

1st 24 hrs. Nat. \_\_\_\_\_

1st 24 hrs. after shot \_\_\_\_\_

Gas \_\_\_\_\_ Cu. Ft.

Dry Hole \_\_\_\_\_

Abandoned \_\_\_\_\_

Date

AUG 17 1922

19

A. D. Hatfield

Scout

Rush

KANSAS

Map No. 74 Sec. 1 Twp. 18 R. 16WWell No. 1 Hall Est.Aylward Prod. Company

Contractor

ABANDONED

C NE SW

660 Ft. from N. Line

\_\_\_\_\_ Ft. from S. Line

660 Ft. from E. Line

\_\_\_\_\_ Ft. from W. Line

## SECTION PLAT

	0		

Location \_\_\_\_\_

Rig up \_\_\_\_\_

Drilling and Remarks:

*No shows**DYA*

## RECORD

Cased 7 in., 3517 ft.Sand Granite Wash 3535

Gas \_\_\_\_\_

Oil \_\_\_\_\_

Total Depth 3560

## PRODUCTION

1st 24 hrs. Nat. \_\_\_\_\_

1st 24 hrs. after shot \_\_\_\_\_

Gas \_\_\_\_\_ Cu. Ft.

Dry Hole \_\_\_\_\_

Abandoned \_\_\_\_\_

Date

SEP 14 1938 19 H. D. Hatfield Scout