


Form 51-5M-2-29-34703
Map No. *Rush* *2* *18* *16*
Well No. *KANSAS* Sec. *2* Typ. *18* R. *16*
1- Mohr Farm
Syndicate Oil Company

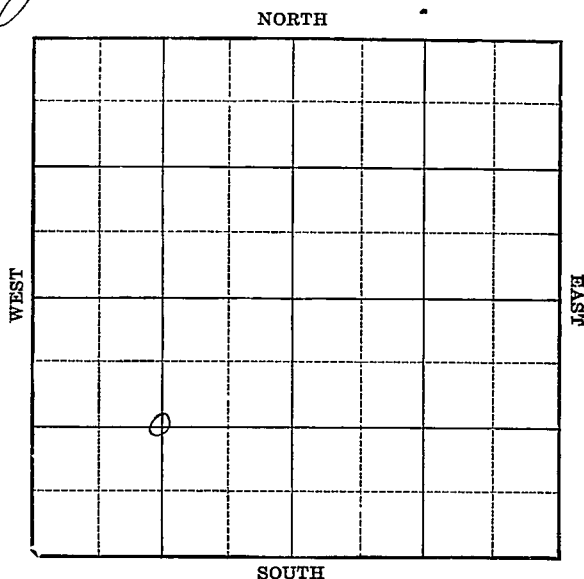

Location _____

Drilling Remarks _____

Rig Up _____

Drilling Remarks _____

RECORD

Cased _____ in. _____ ft.

Sand _____

Gas _____

Oil _____

Total Depth _____

PRODUCTION

1st 24 hrs. Nat. _____

1st 24 hrs. after shot _____

Gas _____ cu. ft. _____

Dry Hole _____


Abandoned _____

Rush
Map No. **KANSAS** Sec. *2* Twp. *18* R. *16^w*

Well No. *1- Mohr* Farm

Syndicate Oil Company

NORTH

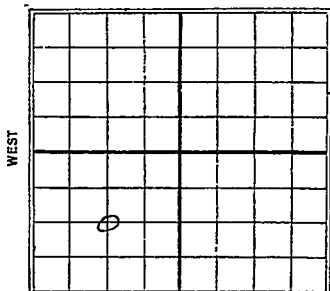

_____ Ft. from N. Line

1320 Ft. from S. Line

_____ Ft. from E. Line

1320 Ft. from W. Line

SOUTH

Date

REPORT


<i>5/7</i>	<i>Ro G.</i>
<i>5/14</i>	
<i>5/21</i>	<i>Rig</i>
<i>5/28</i>	<i>Spud 75'</i>
<i>6/4</i>	<i>hrlg. 380'</i>
<i>6/11</i>	<i>" 800'</i>
<i>6/18</i>	<i>" 1210'</i>
<i>6/25</i>	<i>S.D. 1210'</i>
<i>7/2</i>	<i>hrlg. 1825'</i>
<i>7/9</i>	<i>" 2300'</i>
<i>7/16</i>	<i>" 2540'</i>
<i>7/23</i>	<i>" 2670'</i>
<i>7/30</i>	<i>" 3200'</i>
<i>8/6</i>	<i>Show gas 3325'</i>
	<i>" " 3410'</i>
	<i>T.D. 3480 S.D.</i>
<i>8/13</i>	<i>6" - 3480'</i>
	<i>hrlg. 3576'</i>
<i>8/20</i>	<i>" 3590'</i>
<i>8/27</i>	<i>" 3670'</i>
<i>9/3</i>	<i>S.D. 3670'</i>
<i>9/10</i>	<i>—</i>

9/17- Top Granite wash 3504
TD 3763
Abandoned.

Kush
 Map No. **KANSAS** Sec. *2* Twp. *18* R. *16W*
 Well No. *1 Mohr*

Syndicate Oil Company
 Contractor

SECTION PLAT

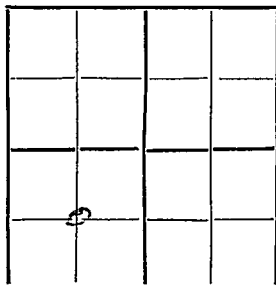

.....Ft. from N. Line

1320 Ft. from S. Line

.....Ft. from E. Line

1820 Ft. from W. Line

FIRST REPORTS

Location.....

Rig up.....

Drilling and Remarks:

RC 1

RECORD

Cased.....in.,ft.

Sand.....

Gas.....

Oil.....

Total Depth.....

PRODUCTION

1st 24 hrs. Nat.....

1st 24 hrs. after shot.....

Gas.....Cu. Ft.

Dry Hole.....

Abandoned.....

Date

MAY 7 1930


192

J. LEWIS Scout

Map No. KANSAS Sec. 2 Twp. 18 R. 16 WWell No. 1 MohrSynthetic Oil Company

Contractor

SECTION PLAT

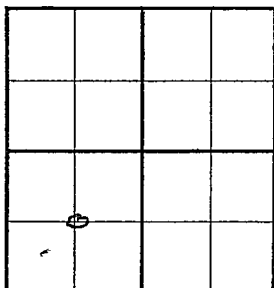

_____ Ft. from N. Line

1320 Ft. from S. Line

_____ Ft. from E. Line

1820 Ft. from W. Line

ABANDONED

Location _____

Rig up _____

Drilling and Remarks: *

Top. Granite
Wash 3504

RECORD

Cased _____ in., _____ ft.

Sand _____

Gas _____

Oil _____

Total Depth 3763

PRODUCTION

1st 24 hrs. Nat. _____

1st 24 hrs. after shot _____

Gas _____ Cu. Ft.

Dry Hole _____

Abandoned _____

Date

SEP 17 1930S. J. LEWIS Scout