


Rush

KANSAS

SECTION 8 TOWNSHIP 18S RANGE 16W

WELL NO. #1 Luft-Maneth

COMPANY Solar Oil Co.

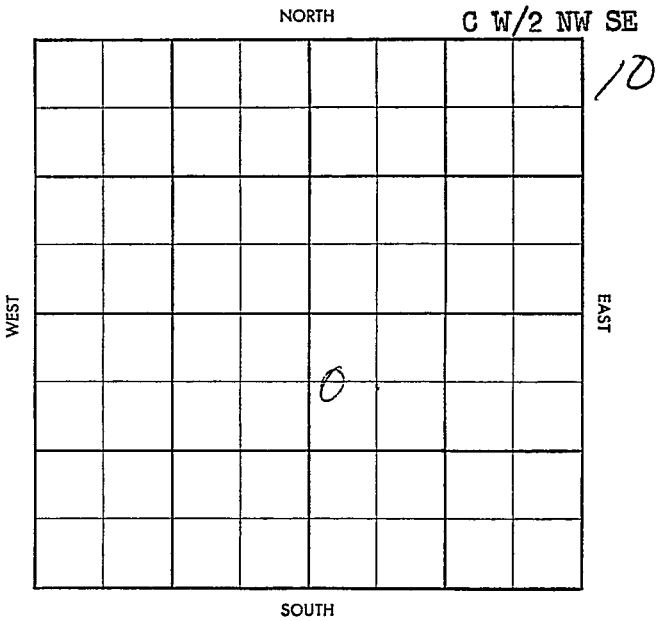

~~100~~ ~~1000~~ ~~1000~~


County Rush Elev. _____
 Sec. 8 Twp. 18 Rge. 16W
 Company Solar Oil Co.
 Farm Name Luft-Maneth No. 1

TOPS	DEPTH	LOG	DATUM
Anh.	1003		
Tp.			
H.			
Tr.			
Dg.			
B.L.			
L.			
K.C.			
B.K.C.			
Ce.			
C.			
M.			
M.			
K.			
Mz.			
Mq.			
V.			
S.			
S.			
A.			
R.			
Pf.			
G.			
T.D.			

Loc. in Sec. _____
C W/2 NW SE

Geol. _____
 Contr. _____
Lewis Drlg.

Pool _____
Otis-Albert

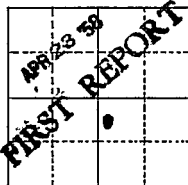

Date Comm. 4/17/58
8" @ 1013 w/425, Drlg. Ahead.

Co.

Lse.

No.

Sec.

T.

R.

~~Twp.~~ ~~Pool~~
~~Co.~~ ~~Face~~

S-513-B

County Rush Elev 1946KB
 Sec. 8 Twp. 18 Rge. 16W
 Company Solar Oil Co.
 Farm Name Luft-Maneth No. 1

TOPS	DEPTH	LOG	DATUM
Anh.	1003		
Tp.			
H.	3165		
Tr			
Dg.			
B.L.			
L.	3224		
K.C.			
B.K.C.	3429		
Ce.			
C.	3457		
Mr. <u>C sd</u>	3474		
M.			
K.			
Mz.			
Mq.			
V.			
S.			
S.			
A.			
R.			
Pf.			
G. <u>W</u>	3488		
<u>G-</u>	3492		
T.D.	3500		

Loc. in Sec. C W/2 NW SE
 Geol. _____
 Contr. Lewis Drlg.
 Pool Otis-Albert

ABANDONED
 0
 APR 30 '58

Date Comm. 4/17/58
8" & 1013 w/425, Drlg. Ahead. APR 30 '58
end 3480 - 3500 rec 20' no Log
DST 3478 - 3500 1hr 15' M BHP
failed

DOA

Co
 Sec
 T
 R