

Rush

Map No. KANSAS Sec. 10 Twp. 18 R. 16 W


Well No. 1-B J. B. Mohr Farm
Inter State Prod. Company

1320 Ft. from N. Line

_____ Ft. from S. Line

1320 Ft. from E. Line

_____ Ft. from W. Line

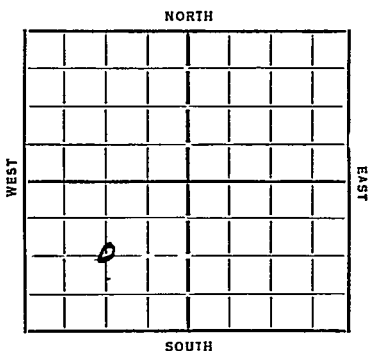

Date	REPORT
1934	
10/31	Moving in
11/8	Rig
11/15	11/22
11/28	Log 820 15 1/2 407
12/6	" 1510
12/13	
12/21	Log 2525 10" 2248 S.G. 2280
12/27	
1/3/35	2915 log tool
1/19	Log 3220
1/17	" 3320
1/24	8" 3400 Run 6" 3460
1/24	Shy Gas 3230-35 6783332
	Log 3460
1/31	S.G. 3477 Gas Sand 3480
	678 3480
2/6	Sand 3480 TD 3507
	44 M Gas 990 # R.P.

COMPLETED

Map No. 74 Sec. 10 Twp. 18 R. 16W

Well No. 1B- G. B. Mohr

Inter State prod Company

Contractor

FIRST REPORTS

SECTION PLAT

1320 Ft. from N. Line

_____ Ft. from S. Line

1320 Ft. from E. Line

_____ Ft. from W. Line

Location _____

Rig up _____

Drilling and Remarks:

Moving in

RECORD

Cased _____ in., _____ ft.

Sand _____

Gas _____

Oil _____

Total Depth _____

PRODUCTION

1st 24 hrs. Nat. _____

1st 24 hrs. after shot _____

Gas _____ Cu. Ft.

Dry Hole _____

Abandoned _____

Date

10-31-31₁₉

ORVAL MANNSCHRECK

Scout

Map No. 74 Sec. 10 Twp. 18 R. 16W

Well No. 1B - G. B. Mohr

Inter State Prod Company

Contractor

COMPLETED

SECTION PLAT

1320 Ft. from N. Line

..... Ft. from S. Line

1320 Ft. from E. Line

..... Ft. from W. Line

Location.....

Rig up.....

Drilling and Remarks:

44 mil. gas

990 R.P.

RECORD

Cased..... in. ft.

Sand 3480

Gas.....

Oil.....

Total Depth 3507

PRODUCTION

1st 24 hrs. Nat.....

1st 24 hrs. after shot.....

Gas..... Cu. Ft.

Dry Hole.....

Abandoned.....

Date

2-6-35 192

ORVAL MANNSCHRECK

Scout