


Map No. Kans Sec. 25 Twp. 31 R. 2E
 Well No. 5 Churchill Farm
Rotana Pet Company

NORTH

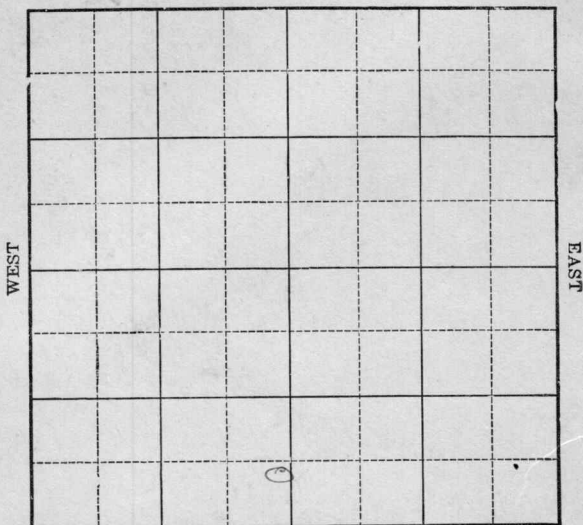

SOUTH

Location _____

Drilling Remarks _____

Rig Up _____

Drilling Remarks _____

RECORD

Cased _____ in. _____ ft.

Sand _____

Gas _____

Oil _____

Total Depth _____

PRODUCTION

1st 24 hrs. Nat. _____

1st 24 hrs. after shot _____


Gas _____ cu. ft.

Dry Hole _____

Abandoned _____

Map No. Trans Sec. 25 Twp. 31 R. 2 E
 Well No. 5 Churchill Farm
Roxana Pet Company

NORTH

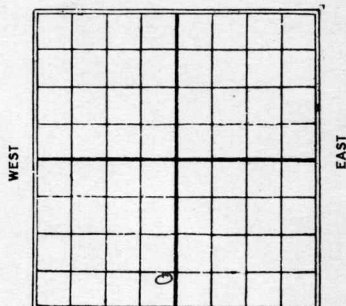

Ft. from N. Line

640 Ft. from S. Line

220 Ft. from E. Line

Ft. from W. Line

1926

Date

REPORT

10/13	Location
10/20	R.O.G.
10/27	Spud
11/3	Drlg 380'
11/10	" 1040
11/17	" 1140
11/24	J.S. 1832 oil 1894 JD1905 swabb 120 bbls 9 hrs
12/1	30 fts shot went off 400' from top of hole
12/8	Same
12/15	—
12/21	C.O.
12/29	—
1927	
1/5	Drlg by pipe
1/12	str. ream @ 1200
1/19	str. ream @ 1323
1/26	Drlg 1470
2/2	T.D. 1547 - fishing
2/9	same
2/16	Run 6" @ 1560 T.D.

4/23 - T.D. 1560 - pipe trouble
3/2 - Drlg 1614 - set 5" @ 1596
3/9 - T.D. 1615 - cementing pipe
3/16 - top sand 1836 oil 1842.
Drlg 1865 - hole full oil in 4 hrs.
3/23 - Top sand 1836
oil 1842 - T.D. 1903
shot 60 gts
1873 - 1903
500 bbls 24 hrs

Map No. **KANSAS** Sec. 25 Twp. 31 R. 2E

Well No. 5 Churchill

Roxana Pet Company

Contractor

SECTION PLAT

_____ Ft. from N. Line

640 Ft. from S. Line

220 Ft. from E. Line

_____ Ft. from W. Line

FIRST REPORTS

Location _____

Rig up _____

Drilling and Remarks:

Location.

RECORD

Cased _____ in., _____ ft.

Sand _____

Gas _____

Oil _____

Total Depth _____

PRODUCTION

1st 24 hrs. Nat. _____

1st 24 hrs. after shot _____

Gas _____ Cu. Ft.

Dry Hole _____

Abandoned _____

Date

OCT 13 1926

S. J. LEWIS

Scout

Map No. **KANSAS** Sec. 25 Twp. 31 R. 2E

Well No. 5 Churchill

Roxana P. & Co. Inc. Company

Contractor

SECTION PLAT

----- Ft. from N. Line

640 Ft. from S. Line

220 Ft. from E. Line

----- Ft. from W. Line

COMPLETED

Location -----

Rig up -----

Drilling and Remarks:

TS. 1836

DC 1842

TD 1903

shot 609 ts.

1873 & 1903

500 & 624 hrs

RECORD

Cased ----- in., ----- ft.

Sand -----

Gas -----

Oil -----

Total Depth -----

PRODUCTION

1st 24 hrs. Nat. -----

1st 24 hrs. after shot -----

Gas ----- Cu. Ft.

Dry Hole -----

Abandoned -----

Date

MAR 23 1927

192

S. J. LEWIS

Scout