



Map No. \_\_\_\_\_ Sec. 25 Twp. 31 R. 2E


Well No. 7-Churchill Farm  
Rosana Pet Corp Company

\_\_\_\_\_ Ft. from N. Line

330 Ft. from S. Line

659 Ft. from E. Line

\_\_\_\_\_ Ft. from W. Line

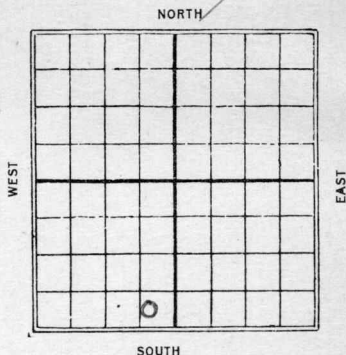

1927

Date

REPORT

|             |                              |
|-------------|------------------------------|
| <u>3/9</u>  | <u>Location</u>              |
| <u>3/16</u> | <u>Rig</u>                   |
| <u>3/23</u> | <u>Spud</u>                  |
| <u>3/30</u> | <u>Drilg 580</u>             |
| <u>4/6</u>  | <u>" 1200</u>                |
| <u>4/13</u> | <u>" 1515</u>                |
| <u>4/20</u> | <u>top sand 1817- Drilg</u>  |
| <u>4/27</u> | <u>5 1817 oil 1855-</u>      |
|             | <u>J.D. 1896</u>             |
|             | <u>shot 80 gts 1855-1896</u> |
|             | <u>444 bbls 24 hrs</u>       |

Map No. **KANSAS** Sec. 25 Twp. 31 R. 2E

Well No. 7 Churchill

Roxana Pet. Co. Company

Contractor

SECTION PLAT

----- Ft. from N. Line  
330 Ft. from S. Line  
659 Ft. from E. Line  
----- Ft. from W. Line

|  |  |  |  |
|--|--|--|--|
|  |  |  |  |
|  |  |  |  |
|  |  |  |  |
|  |  |  |  |

FIRST REPORTS

Location ✓  
Rig up -----  
Drilling and Remarks:

RECORD

Cased ----- in., ----- ft.  
Sand -----  
Gas -----  
Oil -----  
Total Depth -----

PRODUCTION

1st 24 hrs. Nat. -----  
1st 24 hrs. after shot -----  
Gas ----- Cu. Ft.  
Dry Hole -----  
Abandoned -----

Date

MAR 9 1927  
192

S. J. LEWIS Scout

Map No. **KANSAS** Sec. 25 Twp. 31 R. 2E

Well No. 7 Churchill

Roxana P & Corp Company

Contractor

**SECTION PLAT**

|  |   |  |  |
|--|---|--|--|
|  |   |  |  |
|  |   |  |  |
|  |   |  |  |
|  |   |  |  |
|  | 0 |  |  |

----- Ft. from N. Line

330 Ft. from S. Line

659 Ft. from E. Line

----- Ft. from W. Line

**COMPLETED**

Location -----

Rig up -----

Drilling and Remarks:

T.S. 1817

Dil 1855

T.D. 1896

Shot 80 gals. 1855

8 1896

444 8 24 hrs

**RECORD**

Cased ----- in., ----- ft.

Sand -----

Gas -----

Oil -----

Total Depth -----

**PRODUCTION**

1st 24 hrs. Nat. -----

1st 24 hrs. after shot -----

Gas ----- Cu. Ft.

Dry Hole -----

Abandoned -----

Date

APR 27 1927

S. J. LEWIS

Scout