


Rush
18 R. 16 W

Map No. KANSAS Sec. 12 Twp. 18 R. 16 W

Well No. 1- Mauler Farm
Marathon Company

Ft. from N. Line
1320 Ft. from S. Line
Ft. from E. Line
1320 Ft. from W. Line
Elev. 1983

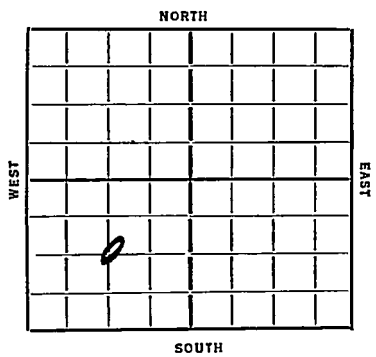

Date	REPORT
10/30	Location
11/7	Log
11/14	Run
11/21	20" 103 Dlg 395
	Ag 2340-45 10" 3355
	Dlg 4675
11/29	TD 425 Cen 15"
12/6	15" 422 12" 1017
	Dlg 1065
12/13	" 2135 Ag 1880-90
12/19	" 2935
12/26	" 3355 8" 3335
12/36	Top Reagan sand 3508
1/8	Est 47m Gas Run 6" pipe
	sand 3508
	TD 3540
	47m Gas.
	COMPLETED

Map No. 74 Sec. 12 Twp. 18 R. 16W

Well No. 1-Mauler

Marathon Company

Contractor

FIRST REPORTS

SECTION PLAT

Ft. from N. Line

1320 Ft. from S. Line

Ft. from E. Line

1320 Ft. from W. Line

Location

Rig up

Drilling and Remarks:

RECORD

Cased.....in.,ft.

Sand.....

Gas.....

Oil.....

Total Depth.....

PRODUCTION

1st 24 hrs. Nat.....

1st 24 hrs. after shot.....

Gas.....Cu. Ft.

Dry Hole.....

Abandoned.....

Date

ORVAL MANNSCHRECK

10-30-35 192.....

Scout


Map No. 74 Sec. 12 Twp. 18 R. 16W

Well No. 1 - Mauler

marathon Company

Contractor

SECTION PLAT

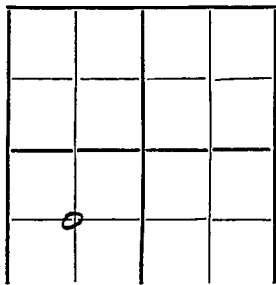

.....Ft. from N. Line

1320 Ft. from S. Line

.....Ft. from E. Line

1320 Ft. from W. Line

COMPLETED

Location.....

Rig up.....

Drilling and Remarks:

47 M. gas

RECORD

Cased..... in., ft.

Sand 3508

Gas.....

Oil.....

Total Depth 3540

PRODUCTION

1st 24 hrs. Nat.....

1st 24 hrs. after shot.....

Gas..... Cu. Ft.

Dry Hole.....

Abandoned.....

Date

JAN 8 1936

ORVAL MANNSCHRECK

.....192.....

.....Scout