


Section 8 Township 18 Range 16W

Well No. 1 Luft

Company M. F. Powers

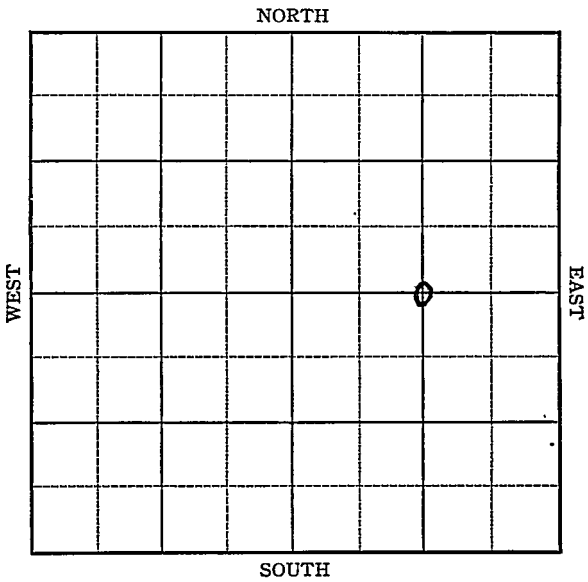

Rush

KANSAS


Map No. 74 Sec. 8 Twp. 18 R. 16WWell No. 1 LuftM. F. Powers

Company

FIRST REPORT

Contractor

SECTION PLAT

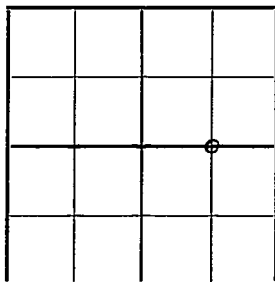C $E\frac{1}{2}$ Sec.
2640 Ft. from N. Line Ft. from S. Line1320 Ft. from E. Line Ft. from W. Line

WILDCAT

RECORD

Location _____

Cased _____ in., _____ ft.

Rig up _____

Sand _____

Drilling and Remarks:

Gas _____

13" - 208

Oil _____

Anhy. 1011

Total Depth _____

8" - 1016Lans. 3260Drlg.

PRODUCTION

1st 24 hrs. Nat. _____

1st 24 hrs. after shot _____

Gas _____ Cu. Ft.

Dry Hole _____

Abandoned _____

Date

JUN 1 8 1941 19S. J. LEWIS Scout

