

17 MSAS


Form 51-5M-4-36-Palace

Rush

Section 9 Township 18 Range 16-W

Well Number 1-Schmidt

Company Inter-State Prod.

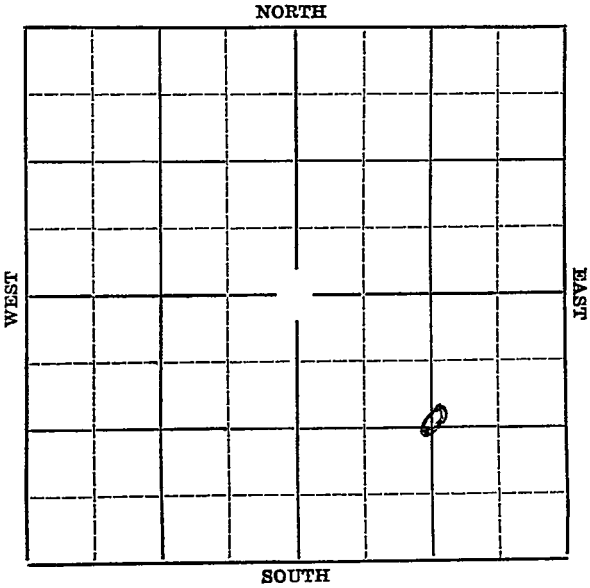

KANSAS

Rush

Map No. _____ Sec. 9 Twp. 18 R. 16W

Well No. #1 Schmidt Farm _____


Enter-State Prod. Company _____

_____ Ft. from N. Line

1320' Ft. from S. Line

1320' Ft. from E. Line

_____ Ft. from W. Line

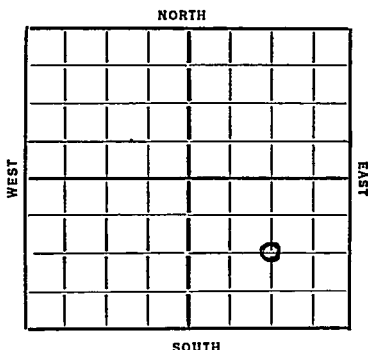

Date	REPORT
1956	
5/13	Drlg. 405'.
5/21	12" @ 1003'. WOC.
5/28	Drlg. 1420'.
6/4	Drlg. 2230'.
6/11	Drlg. 2855'. 10" @ 2357'.
6/18	8" @ 3260'. Drlg. 3465'.
6/25	5 1/2 million gas. 3490-97'. Drlg. 3506'.
8/2	Drlg. 3533'.
7/9	Granite 3508' to 3559'. Plug back to 3497'. Shot 5 qts. 6 million cubic feet of gas.
7/16	--7/23--
7/29	36-Gas sand 3473'-3490'. Granite 3508'. T.D. 3559'. Shot 60 qts 3473'.-3506'. 6 million cubic feet of gas.
	COMPLETED

KANSAS

Map No. 74 Sec. 9 Twp. 15 R. 16 XVWell No. 1 SchmidtInter-State Prod Company

Contractor

SECTION PLAT

 Ft. from N. Line1320 Ft. from S. Line1320 Ft. from E. Line Ft. from W. Line

FIRST REPORT

Location 4Rig up

Drilling and Remarks:

Drill 405'
under

RECORD

Cased in., ft.Sand Gas Oil Total Depth

PRODUCTION

1st 24 hrs. Nat. 1st 24 hrs. after shot Gas Cu. Ft.Dry Hole Abandoned

Date

MAY 13 1936 19S. J. LEWIS Scout

Map No. 74 Sec. 9 Twp. 18 R. 16W

Well No. 1 Schmidt

Inter-State Prod. Company

Contractor

SECTION PLAT

			e

_____ Ft. from N. Line

1320 Ft. from S. Line

1320 Ft. from E. Line

_____ Ft. from W. Line

COMPLETED

Location _____

Rig up _____

Drilling and Remarks:

Gas Sand 3473

3490

Granite 3508.

Blk 60 gts 3473

3506

6 M Gas

RECORD

Cased _____ in., _____ ft.

Sand _____

Gas _____

Oil _____

Total Depth 3559

PRODUCTION

1st 24 hrs. Nat. _____

1st 24 hrs. after shot _____

Gas _____ Cu. Ft.

Dry Hole _____

Abandoned _____

Date

JUL 29 1936 19

S. J. LEWIS Scout