


Map No. **KANSAS** Sec. 11 Twp. 18 R. 16 ^{W.}

Well No. F. Hagelgantz Farm _____
Schererhorst Company _____

NORTH

9

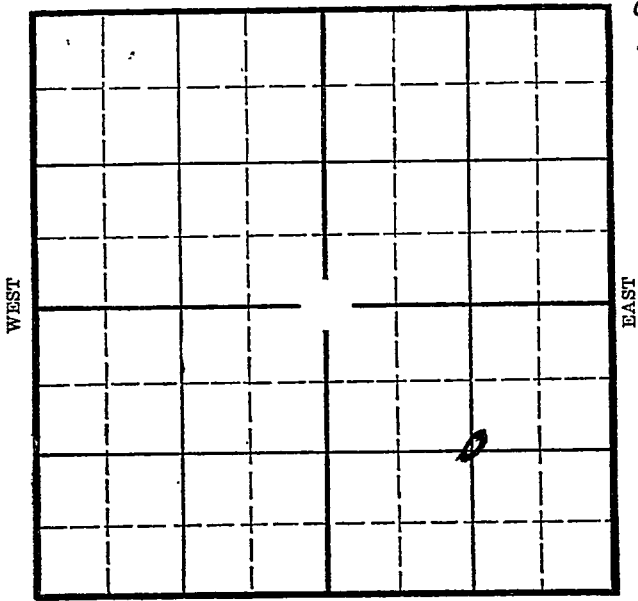

SOUTH

Location _____

Drilling Remarks _____

Rig Up _____

Drilling Remarks _____

RECORD

Cased _____ in. _____ ft.

Sand _____

Gas _____

Oil _____

Total Depth _____

PRODUCTION

1st 24 hrs. Nat. _____

1st 24 hrs. after shot _____

Gas _____ cu. ft. _____

Dry Hole _____

Abandoned _____

Rush

Map No. KANSAS Sec. 11 Twp. 18 R. 16^w


Well No. 1- Hagelgantz Farm
Schumhorn Company

_____ Ft. from N. Line

1320 Ft. from S. Line

1320 Ft. from E. Line

_____ Ft. from W. Line

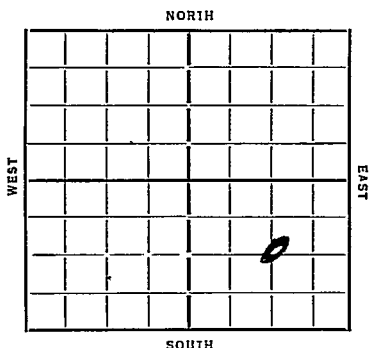

Elevation 1971

Date	REPORT
7/10	Location
7/18	Log
8/8	Log 1535 12" 1012
8/15	" 2285 10" 2235
8/22	Log 2280-90 Gas 2335-40
	Log 2910-15 Log 3065
8/29	KOC 3235 8" 3245
	Log 3270-80 Gas 3383-93
	1000' oil 16 hrs.
9/6	8" 3358
	Swab 1/2 Bbls per hr
	T 3400 Many acidize
10/3	6" 3495 Reagent 3495
	T 3523 55 M Gas.
10/8	Swab 3495
	T 3523
	55 M Gas.

COMPLETED

Map No. 74 Sec. 11 Twp. 18 R. 16W

Well No. 1-Hagelgantz

Schermerhorn Company

Contractor

FIRST REPORTS

SECTION PLAT

			0

.....Ft. from N. Line

1320 Ft. from S. Line

1320 Ft. from E. Line

.....Ft. from W. Line

Location ✓

Rig up.....

Drilling and Remarks:

RECORD

Cased.....in.,ft.

Sand.....

Gas.....

Oil.....

Total Depth.....

PRODUCTION

1st 24 hrs. Nat.....

1st 24 hrs. after shot.....

Gas.....Cu. Ft.

Dry Hole.....

Abandoned.....

Date

ROYAL MANSCHRECK

7-10-35 192.....

Scout

Map No. 74 Sec. 11 Twp. 18 R. 16^W

Well No. 1-Hagelgantz
Schermerhorn Company

Contractor

~~UNRECORDED~~

SECTION PLAT

..... Ft. from N. Line

1320 Ft. from S. Line

1320 Ft. from E. Line

..... Ft. from W. Line

Location.....

Rig up.....

Drilling and Remarks:

55 m gas

RECORD

Cased..... in. ft.

Sand 3495

Gas.....

Oil.....

Total Depth 3523

PRODUCTION

1st 24 hrs. Nat.....

1st 24 hrs. after shot.....

Gas..... Cu. Ft.

Dry Hole.....

Abandoned.....

Date

ORVAL MANNSCHRECK

10-8-35 192.....

Scout