


Map No. KANSAS Sec. 11 Twp. 18 R. 16 W

Well No. 1- Mohr Farm
Milmac Oil Company

Schermerhorn NORTH 0 + 1/2 3

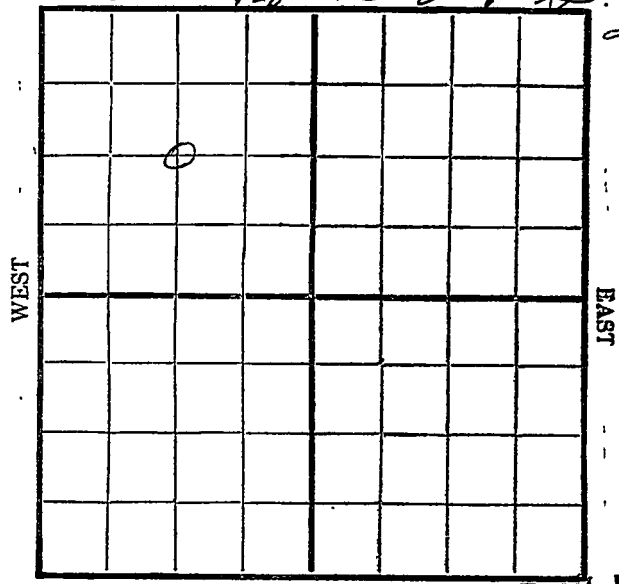

Location _____
Drilling Remarks _____

Rig Up _____
Drilling Remarks _____

RECORD


Cased _____ in. _____ ft.
Sand _____
Gas _____
Oil _____
Total Depth _____

PRODUCTION

1st 24 hrs. Nat. _____
1st 24 hrs. after shot _____
Gas _____ cu. ft. _____
Dry Hole _____
Abandoned _____

Map No. KANSAS Sec. 11 Twp. 18 R. 16^w
Well No. 1- Mohr Farm
~~Wilma Oil~~ Company
Schermerhorn B & S.

1320 Ft. from N. Line
_____ Ft. from S. Line
_____ Ft. from E. Line
1320 Ft. from W. Line

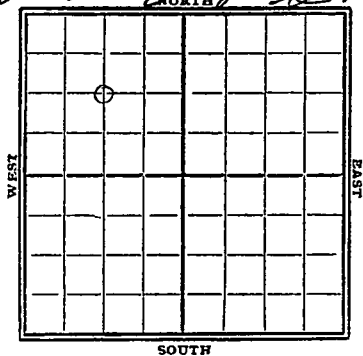

1929

Date	REPORT	O. W. D. D
8/14	Location	
8-21	✓	
8/28	—	
9/4	—	
9/11	Bldg Rig	
9/18	Rig	
9/25	Shut	
10/2	Shut down	
10/9	—	
10/16	—	
10/23	—	
10/30	—	
11/6	—	
11/13	—	
11/20	—	
11/27	—	
12/4	—	
12/11	—	
12/18	—	
12/23	—	
12/30	Spdy. 250'	

1930
1/8- Drlg 480'
1/15- " 750'
1/22- " 915'
1/29- " 1050'
2/5- " 1235'
2/12- S.D. 1710'
2/19- Show gas 1850-
1875 - run 10" -
2210
2/26- Drlg. 2690.
3/5- " 3095.
3/13- At 3506-07 got
(estimated) 35 M gas
(Gorham sand??)
3/15- Top Gorham 3506-08
TD. 3508' = 24 M gas
(gauged)
3/19- S.D. 3508
3/26- Sand 3507-08'
TD. 3508
24 M gas
961 B.T.U.
1125# R.P.
Pomp.

OVER

1936 O.W.D.D

12/16 Old T. D. 3508'.
Fishing liner out.

12/24 Clean out.

12/29 " "

1937

1/7 Clean out 3509'.

1/14 5" @ 3509'. WOC

1/21 Drlg. 3526'. 9 M gas.

1/27 -- Basil Sand 3509

T. D. 3526


27M. Gas

COMPLETED

*Rush*Map No. **KANSAS** Sec. 11 Twp. 18 R. 16 WWell No. 74 1 MohrMilmac Oil Company

Contractor

SECTION PLAT

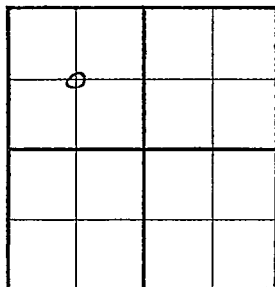1320 Ft. from N. Line

_____ Ft. from S. Line

_____ Ft. from E. Line

1320 Ft. from W. Line

FIRST REPORTS

Location ✓

Rig up _____

Drilling and Remarks: _____

RECORD

Cased _____ in., _____ ft.

Sand _____

Gas _____

Oil _____

Total Depth _____

PRODUCTION

1st 24 hrs. Nat. _____

1st 24 hrs. after shot _____

Gas _____ Cu. Ft.

Dry Hole _____

Abandoned _____

Date

AUG 14 1929

19

S. J. LEWIS Scout

Map No. *KANSAS* Sec. *11* Twp. *18* R. *16W*

Well No. *1 Mo ha*

Philman Oil Company

Contractor


SECTION PLAT

1820 Ft. from N. Line

..... Ft. from S. Line

..... Ft. from E. Line

1820 Ft. from W. Line

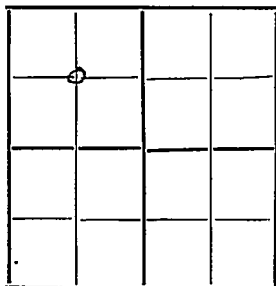

COMPLETED

Location.....

Rig up.....

Drilling and Remarks:

24 M Gas.

961 B.T.U.

1125 Rock Pk.

RECORD

Cased..... in., ft.

Sand *3507 - 3508*

Gas.....

Oil.....

Total Depth *3508*

PRODUCTION

1st 24 hrs. Nat.....

1st 24 hrs. after shot.....

Gas..... Cu. Ft.

Dry Hole.....

Abandoned.....

Date

MAR 26 1930 *192* *S. J. LEWIS* Scout

KANSAS


Map No. 74 Sec. 11 Twp. 18 R. 16 W.

Well No. 1 A Moke.

S. Kerner & Son O & G Company

Contractor

SECTION PLAT

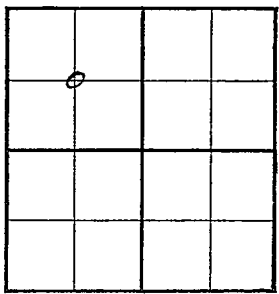

1320 Ft. from N. Line

_____ Ft. from S. Line

_____ Ft. from E. Line

1320 Ft. from W. Line

FIRST REPORT

OWIT

Location _____

Rig up _____

Drilling and Remarks:

Was Milmac Oil
Old #11 3508

fishing liner out

RECORD

Cased _____ in., _____ ft.

Sand _____

Gas _____

Oil _____

Total Depth _____

PRODUCTION

1st 24 hrs. Nat. _____

1st 24 hrs. after shot _____

Gas _____ Cu. Ft.

Dry Hole _____

Abandoned _____

Date

DEC 16 1936

19

S. J. LEWIS

Scout


Map No. 74 Sec. 11 Twp. 18 R. 16W

Well No. 1 A. Mohr.

Schermershorn Company

Contractor

SECTION PLAT

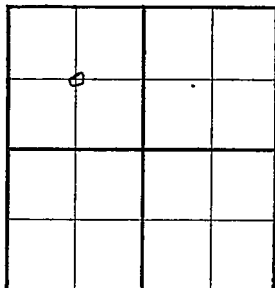

1320 Ft. from N. Line

_____ Ft. from S. Line

_____ Ft. from E. Line

1320 Ft. from W. Line

COMPLETED

Location _____

Rig up _____

Drilling and Remarks:

Basil Sand
3509

27 M. Gas.

RECORD

Cased _____ in., _____ ft.

Sand _____

Gas _____

Oil _____

Total Depth 3526.

PRODUCTION

1st 24 hrs. Nat. _____

1st 24 hrs. after shot _____

Gas _____ Cu. Ft.

Dry Hole _____

Abandoned _____

Date

JAN 27 1937 19

S. J. LEWIS

Scout