


Summer

Map No. MAN Sec. 25 Twp. 31 R. 2E

Well No. 3 Churchill Farm

Roxana Pet Corp. Company

NORTH

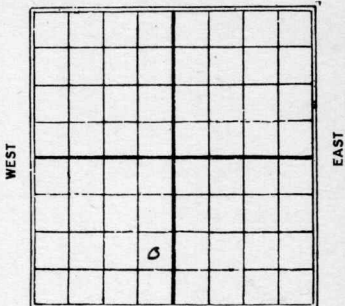

..... Ft. from N. Line

1100 Ft. from S. Line

220 Ft. from E. Line

..... Ft. from W. Line

1926

Date

REPORT

8/25	Rig
9/1	rigging
9/8	Spud 195'
9/15	Drill 540
9/22	" 1260
9/29	Top sd. 1826'
10/6	no report High water
10/13	J.S. 1823 - Oil 185-6
	J.D. 1883 - 260 bbls
	swabbed, 60/75 bbls

Map No. 1 **KANSAS** Sec. 25 Twp. 31 R. 25

Well No. 3 Churchill

Roxana Petroleum Company

Contractor

SECTION PLAT

	0		

----- Ft. from N. Line

1100 Ft. from S. Line

220 Ft. from E. Line

----- Ft. from W. Line

FIRST REPORTS

Location -----

Rig up -----

Drilling and Remarks:

Rig.

RECORD

Cased ----- in., ----- ft.

Sand -----

Gas -----

Oil -----

Total Depth -----

PRODUCTION

1st 24 hrs. Nat. -----

1st 24 hrs. after shot -----

Gas ----- Cu. Ft.

Dry Hole -----

Abandoned -----

Date

AUG 25 1926

S. J. LEWIS

Scout

Map No. 1 **KANSAS** Sec. 25 Twp. 31 R. 2E

Well No. 3 Churchill

Roxana P. & Co. Company

Contractor

SECTION PLAT

		o	

----- Ft. from N. Line

1120 Ft. from S. Line

220 Ft. from E. Line

----- Ft. from W. Line

COMPLETED

Location -----

Rig up -----

Drilling and Remarks:

7/8 1823

0:01856

7/11 1883

260 yds. swatted

Shot 60 lbs.

750 yds.

RECORD

Cased ----- in., ----- ft.

Sand -----

Gas -----

Oil -----

Total Depth -----

PRODUCTION

1st 24 hrs. Nat. -----

1st 24 hrs. after shot. -----

Gas ----- Cu. Ft.

Dry Hole -----

Abandoned -----

Date -----

OCT 13 1926

S. J. LEWIS

192

Scout