


Map No. Sumner Sec. 25 Twp. 31 R. 2E
 Well No. 4 - Churchill Farm
Roxana Pet Corp Company

NORTH

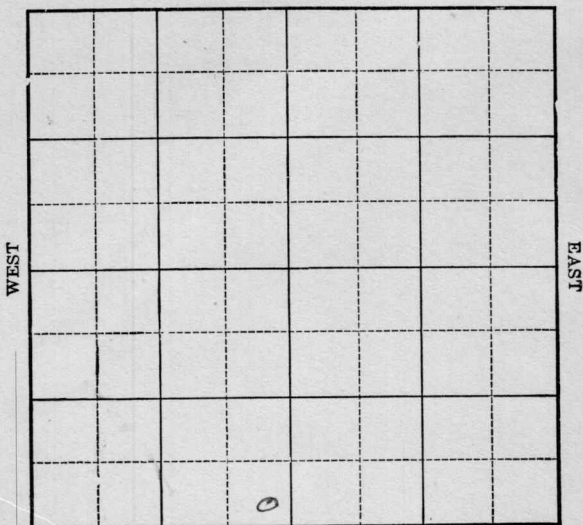

SOUTH

Location _____

Drilling Remarks _____

Rig Up _____

Drilling Remarks _____

RECORD

Cased _____ in. _____ ft.

Sand _____

Gas _____

Oil _____

Total Depth _____

PRODUCTION

1st 24 hrs. Nat. _____

1st 24 hrs. after shot _____


Gas _____ cu. ft.

Dry Hole _____

Abandoned _____

Map No. Sumner Sec. 25 Twp. 31 R. 2 E
 Well No. 4 Churchill Farm
Roxana Pet Company

NORTH

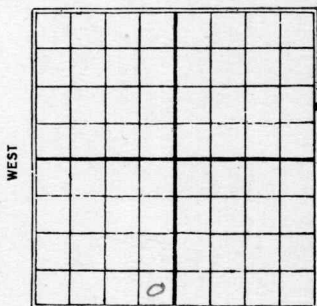

Ft. from N. Line

220 Ft. from S. Line220 Ft. from E. Line

Ft. from W. Line

SOUTH

Date

REPORT

1926

Date	REPORT
<u>10/6</u>	<u>Location</u>
<u>10/13</u>	<u>location</u>
<u>10/20</u>	<u>Rig</u>
<u>10/27</u>	<u>rigging up</u>
<u>11/3</u>	<u>Spud</u>
<u>11/10</u>	<u>Drly 555</u>
<u>11/17</u>	<u>" 1221</u>
<u>11/24</u>	<u>" 1650</u>
<u>12/8</u>	<u>TS 1827' Oil 1847'-55'</u>
	<u>T.D. 1895' - 1100 bbls nat.</u>
	<u>shot 80 gts 1849' to 1895'</u>
	<u>1581 bbls 24 hrs flow & swab</u>

Map No. _____ Sec. 23 Twp. 31 R. 25

Well No. 4 Churchill

Roxana Pet Corp. Company

----- Contractor

SECTION PLAT

Ft. from N. Line

220 Ft. from S. Line

220 Ft. from E. Line

Ft. from W. Line

FIRST REPORTS

Location -----

Rig up -----

Drilling and Remarks:

Location.

RECORD

Cased_____in., _____ ft.

Sand -----

Gas -----

Oil-----

Total Depth_____

PRODUCTION

1st 24 hrs. Nat. -----

1st 24 hrs. after shot-----

Gas-----Cu. Ft.

Dry Hole_____

Abandoned-----

Date _____

OCT 6 1926

S. J. LEWIS

192 Scout

Map No. KANSAS Sec. 25 Twp. 31 R. 2E

Well No. 4 Churchill

Roxana Pet. Corp. Company

Contractor

SECTION PLAT

_____ Ft. from N. Line

220 Ft. from S. Line

220 Ft. from E. Line

_____ Ft. from W. Line

COMPLETED

Location _____

Rig up _____

Drilling and Remarks:

MS. 1827

Oil 1847-55

MS 1895

1100 ft. Na. &

shot 809 to 1849

& 1895

1581 ft. 24/10

Flow & swab.

Date

RECORD

Cased _____ in., _____ ft.

Sand _____

Gas _____

Oil _____

Total Depth _____

PRODUCTION

1st 24 hrs. Nat. _____

1st 24 hrs. after shot _____

Gas _____ Cu. Ft.

Dry Hole _____

Abandoned _____

DEC 8 1921

S. J. LEWIS

Scout