
Form 51—5M—10-26—Mid-West Sumner

Map No. 15 Sec. 25 Twp. 31 R. 2E

Well No. 6 - Churchill Farm

Roxana Pet Corp. Company

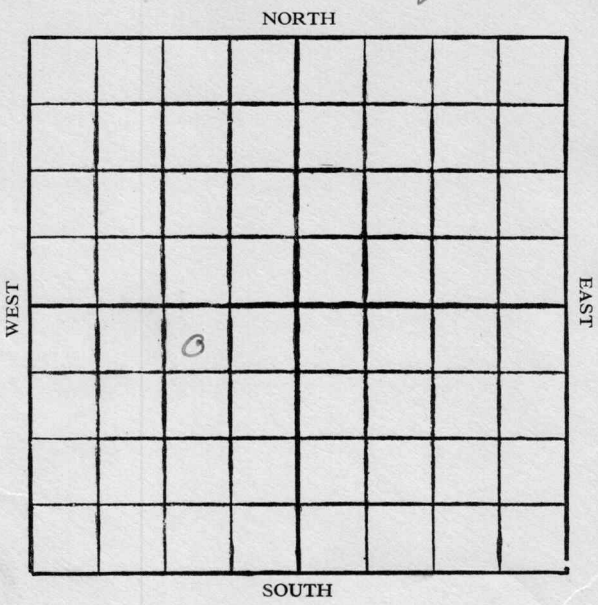

Location	Rig Up
Drilling Remarks	Drilling Remarks
RECORD	PRODUCTION
Cased ..... in. ..... ft.	1st 24 hrs. Nat.
Sand	1st 24 hrs. after shot
Gas	Gas ..... cu. ft.
Oil	Dry Hole
Total Depth	Abandoned

Form 252A—5M—10-26—24951

Sumner

Map No. Kansas Sec. 25 Twp. 31 R. 2E

Well No. 6 Churchill Farm


Roxana Pet Corp Company

330 Ft. from N. Line

Ft. from S. Line

960 Ft. from E. Line

Ft. from W. Line

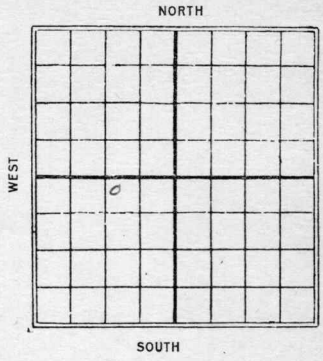

Date 1926	REPORT
12/29	Location
1927	
1/5	Spud
1/12	Drlg 935
1/19	" 1700
1/26	top sand 1819 - Oil 1859
	T. D. 1900
	240 bbls. - Natural
	Shot 80 qts - 1860-1900
	150 bbls.

Form 3—1M Blks. 3-23-11959.

Geneseo


Map No. 1 KANSAS Sec. 25 Twp. 21 R. 2E

Well No. 6 Churchill

Roxana Pet Corp. Company

Contractor

SECTION PLAT

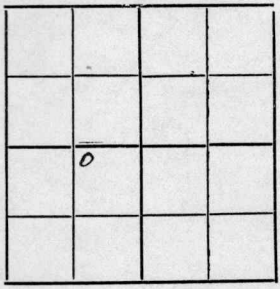

230 Ft. from N. Line

Ft. from S. Line

960 Ft. from E. Line

Ft. from W. Line

FIRST REPORTS

Location 1

Rig up

Drilling and Remarks:

RECORD

Cased in., ft.

Sand

Gas

Oil

Total Depth

PRODUCTION

1st 24 hrs. Nat.

1st 24 hrs. after shot

Gas Cu. Ft.

Dry Hole

Abandoned

Date

DEC 29 1926 192

S. J. LEWIS Scout

Form 26—1M Bks.—3-23-41959.

Sumner


Map No. KANSAS Sec. 25 Twp. 31 R. 2E

Well No. 6 Churchill

Roxana Pet. Corp. Company

Contractor

SECTION PLAT

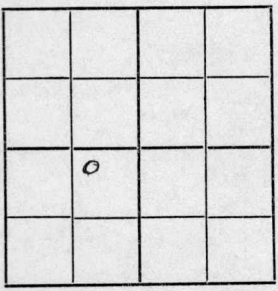

330 Ft. from N. Line

Ft. from S. Line

960 Ft. from E. Line

Ft. from W. Line

COMPLETED

Location

Rig up

Drilling and Remarks:

T.S. 1819
O.C. 1859
T.D. 1900
240 88 ls Nad.
Shot 80 qts.
1860-1900
750 88 ls.

RECORD

Cased in., ft.

Sand

Gas

Oil

Total Depth

PRODUCTION

1st 24 hrs. Nat.

1st 24 hrs. after shot

Gas Cu. Ft.

Dry Hole

Abandoned

Date

JAN 26 1927 192

S. J. LEWIS Scout