


Map No. *Kansas* Sec. *33* Twp. *27* R. *7*

Well No. *5 Cleary* Farm

John Rogers Company

NORTH

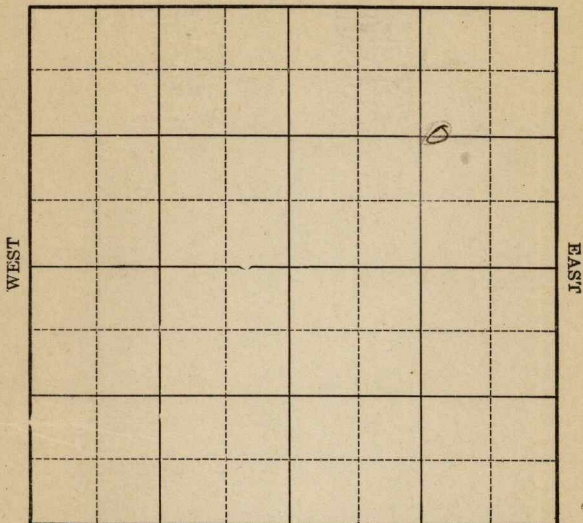

SOUTH

Location _____

Drilling Remarks _____

Rig Up _____

Drilling Remarks _____

RECORD

Cased _____ in. _____ ft.

Sand _____

Gas _____

Oil _____

Total Depth _____

PRODUCTION

1st 24 hrs. Nat. _____

1st 24 hrs. after shot _____

Gas _____ cu. ft.

Dry Hole _____

Abandoned _____

Butler

R10 KANSAS Map No. Sec. *33* Twp. *27* R. *7*

Well No. *5 Cleary*

John Rogers Company Contractor


SECTION PLAT

1320 Ft. from N. Line

----- Ft. from S. Line

1070 Ft. from E. Line

----- Ft. from W. Line

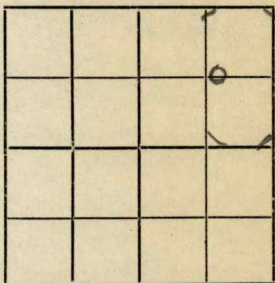

FIRST REPORTS

Location -----

Rig up -----

Drilling and Remarks:

RECORD

Cased ----- in., ----- ft.

Sand -----

Gas -----

Oil -----

Total Depth -----

PRODUCTION

1st 24 hrs. Nat. -----

1st 24 hrs. after shot -----

Gas ----- Cu. Ft.

Dry Hole -----

Abandoned -----

Date

MAR 11 1926

CHAS. L. SHERWOOD

----- 192 ----- Scout

Button

Map No. *K10* **KANSAS** Sec. *33* Twp. *27* R. *7*

Well No. *5* *Clary*

John Rogers Company

Contractor

COMPLETED

SECTION PLAT

1320 Ft. from N. Line

_____ Ft. from S. Line

1070 Ft. from E. Line

_____ Ft. from W. Line

Location _____

Rig up _____

Drilling and Remarks:

100' 100' BS

RECORD

Cased _____ in., _____ ft.

Sand *2740-2785*

Gas _____

Oil _____

Total Depth *2785*

PRODUCTION

1st 24 hrs. Nat. _____

1st 24 hrs. after shot _____

Gas _____ Cu. Ft.

Dry Hole _____

Abandoned _____

Date

APR 28 1926

192

CHAS. L. SHERWOOD

Scout