KANSAS


Form 51—5M—7-39—Palace

Barton

Section 13 Township 20 Range 12-W

Well No. #1 Schlessiger "A"

Company Shell

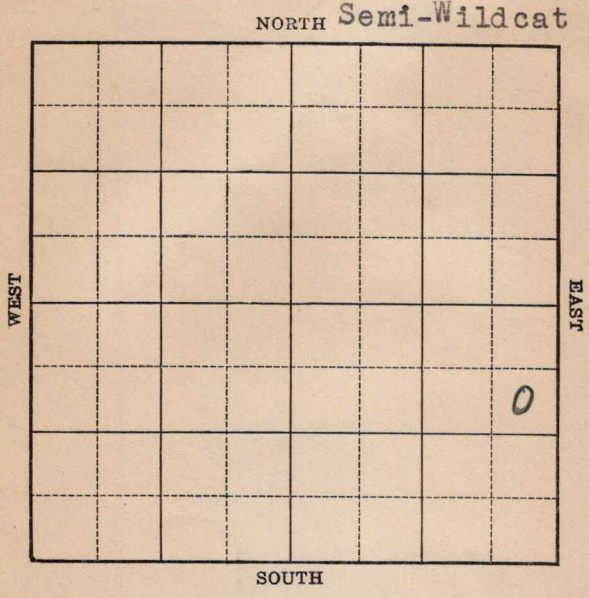

FORM 252-A 5M KANSAS Barton

Sec. 13 Twp. 20 R. 12-W

Well No. #1 Schlessiger "A" Farm

Shell Company


(Semi-Wildcat)

992 Ft. from N. Line

_____ Ft. from S. Line

330 Ft. from E. Line

_____ Ft. from W. Line

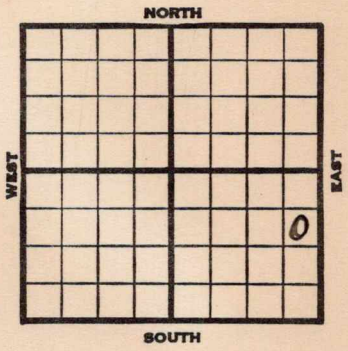

Elev. 1793

1939	REPORT
10/11	Rotary
	Drlg. 60'
10/19	8" - 253' Drlg. 2408'
10/26	Topeka 2689' Lans. 3100'
	Arb. 3309' 4" - 3310' RUST.
11/2	T.D. 3342' 4000 acid. Testing.
11/9	Swab 195 oil 7 hours.
11/16	" " " "
11/23	" " " "
11/28	Arb. 3309'
	4" - 3310'
	T.D. 3342'
	4000 acid.
	Potential, Pump 146 oil & 125 water.
	COMPLETED

Form 26—1M Bks.—2-29

Barton KANSAS

Map No. 46 Sec. 13 Twp. 20 R. 12W

Well No. 1 Schlessiger "A"

Shell Company

Contractor

FIRST REPORT

SE NE SE


992 Ft. from N. Line

Ft. from S. Line

330 Ft. from E. Line

Ft. from W. Line

SECTION PLAT

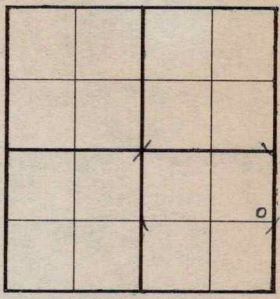

SEMI-WILDCAT

Location

Rig up

Drilling and Remarks:

Rotary

Drlg. 60'

RECORD

Cased in., ft.

Sand

Gas

Oil

Total Depth

PRODUCTION

1st 24 hrs. Nat.

1st 24 hrs. after shot

Gas Cu. Ft.

Dry Hole

Abandoned

Date

OCT 11 1939 19

S. J. LEWIS Scout

Form 26—1M Bks.—2-29 Barton KANSAS

Map No. 46 Sec. 13 Twp. 20 R. 12W

Well No. 1 Schlessiger "A"

Shell Company

Contractor

COMPLETED

SE NE SE

992 Ft. from N. Line


Ft. from S. Line

330 Ft. from E. Line

Ft. from W. Line

SEMI-WILDCAT

SECTION PLAT

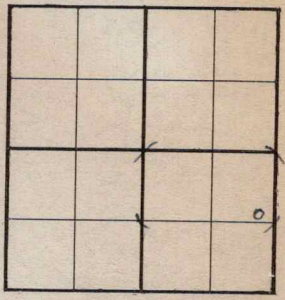

Location .

Rig up

Drilling and Remarks:

Gr 3309

4" @ 3310

4000 Acid

Pump 146 oil and

125 Water R D

RECORD

Cased in., ft.

Sand

Gas

Oil

Total Depth 3342.

PRODUCTION

1st 24 hrs. Nat.

1st 24 hrs. after shot

Gas Cu. Ft.

Dry Hole

Abandoned

Date

NOV 28 1939 19 S. J. LEWIS Scout