


Section 12 Township 18 Range 16-W

Well Number #1-Brack

Company Inter-State Prod.

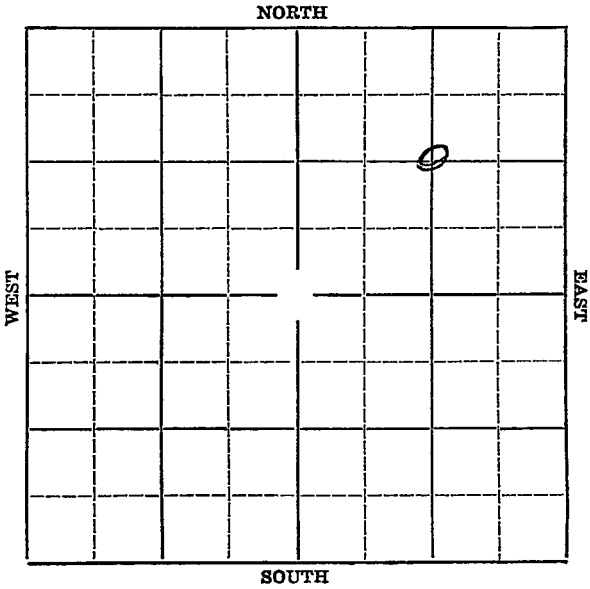

KANSAS

Map No. 74 Sec. 12 Twp. 18 R. 16W

Well No. 1 Brack.

Inter-State Prod. Company

Contractor

SECTION PLAT

1320 Ft. from N. Line

_____ Ft. from S. Line

1320 Ft. from E. Line

_____ Ft. from W. Line

FIRST REPORT

Location ✓

Rig up _____

Drilling and Remarks:

RECORD

Cased _____ in., _____ ft.

Sand _____

Gas _____

Oil _____

Total Depth _____

PRODUCTION

1st 24 hrs. Nat. _____

1st 24 hrs. after shot _____

Gas _____ Cu. Ft.

Dry Hole _____

Abandoned _____

Date


SEP 2 1936 19 _____ S. J. LEWIS Scout

KANSAS

Map No. 74 Sec. 12 Twp. 18 R. 16WWell No. 1 BrockInter-State Prod. Company

Contractor

SECTION PLAT

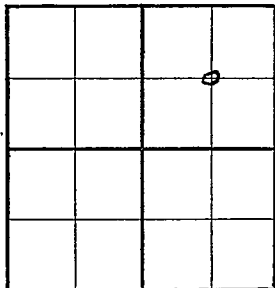1320 Ft. from N. Line

_____ Ft. from S. Line

1320 Ft. from E. Line

_____ Ft. from W. Line

COMPLETED

RECORD

Location _____

Cased _____ in., _____ ft.

Rig up _____

Sand _____

Drilling and Remarks:

Gas _____

Sand 335'

Oil _____

Total Depth 335'4 1/2 M Gas.

PRODUCTION

1st 24 hrs. Nat. _____

1st 24 hrs. after shot _____

Gas _____ Cu. Ft.

Dry Hole _____

Abandoned _____

Date

NOV 10 1936S. J. LEWIS Scout