


Section 14 Township 20 Range 12WWell No. #1 BuckbeeCompany Texas Co.

NORTH

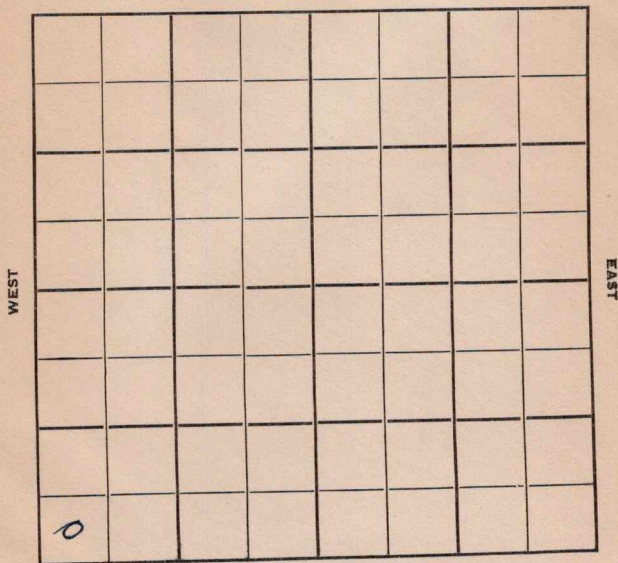

SOUTH

Barton

KANSAS

Sec. 14 Twp. 20 R. 12W

Well No. #1 Buckbee (Lizzie) Farm

Texas Co.

Company

Kuhn

Contractor

Wildcat

Ft. from N. Line

330


Ft. from S. Line

Ft. from E. Line

330

Ft. from W. Line

SW SW SW

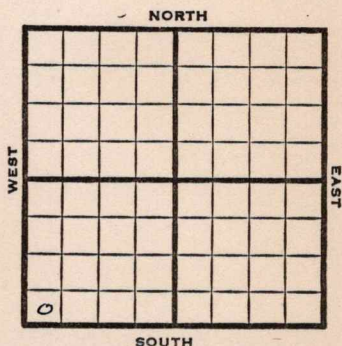

1951

Elev. 1812' REPORT

11/14

RUR

1952

1/2

Spud 11-13-51

D & A TD 3474' 10" @ 595'

Heeb 3000' Br. lime 3120'

Lans. 3138'

DST 3260-75 opeh 1 hr. rec 14' mud

Cong. 3372' Arb. 3384'

TD 3389'

DST 3368-89 open 1 hr. rec 14' mud

DST 3386-3410' open 2 hr. rec 80' OCM

DST 3409-20 open 1½ hr. rec 225' mud & SSO

DST 3412-26 open 2 hr. rec 170' OCM 30' water.

TD 3426 7" @ 3385 S/32 GO

32 GWPH 500 A S/2-1/3 BFPD

S/ 3/4 BO 1¼ BW 1000 A

S/3 BO 7 BW 5 hr. DD 3474'

S/14 BFPH D & A


ABANDONED

County **Barton** State **Kansas**
 Sec. **14** (Blk.) **20** (Sur.) **12W** Map No.

Operator **Texas Co.**

Well No. **1** Farm **Buckbee**

Elev. Location **SW SW SW**

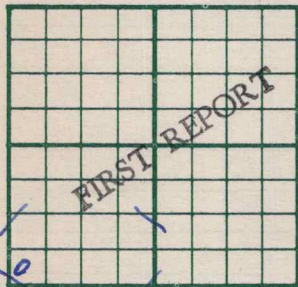

330 Ft. From **S** Line **SW**

330 Ft. From **W** Line Quarter

1st. Report **NOV 14 1951**

Completion

Remarks


Kuhn - Contr.

Spudding Date

Drlg. Data **Wildcat**

RUR

J. E. TYRA

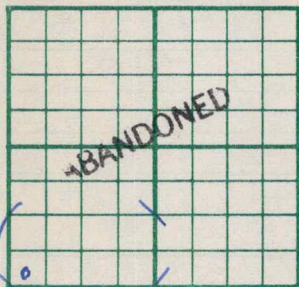County Barton State KansasSec. 14 (Blk. Twp.) 20 (Sur. Rge.) 12W Map No.Operator Texas CompanyWell No. 1 Farm BuckbeeElev. 1812 Location SW SW SW330 Ft. From S Line SW330 Ft. From W Line Quarter

1st. Report

Completion JAN 2 1952Remarks WildcatSpudding Date 11-13-51Drlg. Data D & A TD 347410" @ 595 Heeb. 3000 Br. lime 3120Lans. 3138 DST 3260-75 open 1 hr.Rec. 14' mud Cong. 3372 Arb. 3384TD 3389 DST 3368-89 open 1 hr.Rec. 14' mud DST 3386-3410 open 2 hr.Rec. 80' ocm DST 3409-20 open 1½ hr.Rec. 225' mud & SSO DST 3412-26open 2 hr. Rec. 170' ocm 30' waterTD 3426 7" @ 3385 S/ 32 go 32 gwph500 A S/ 2 1/3 bfph S/ 3/4 bo 1¼ bw1000 A S/ 3 bo 7 bw 5 hr. DD 3474S/ 14 bfphD & A

J. E. TYRA