

Section 20 Township 18 Range 16 W

Well No. # 2 Roth

Company Phillips Pet.

NORTH

10

WEST

EAST

				0			

SOUTH

Rush KANSAS

SEC.	TWP.	R.
20	18	16W ✓

WELL NO. 2 Roth FARM

COMPANY Phillips Petr.

CONTRACTOR Co. Tools


Otis Albert Pool

330 Ft. from N. Line

_____ Ft. from S. Line

_____ Ft. from E. Line

330 Ft. from W. Line

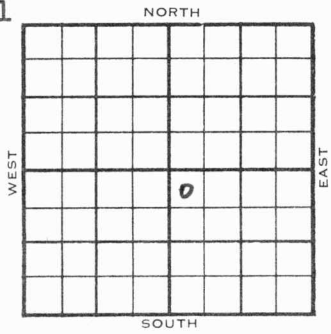

NW NW SE

1954	ELEVATION	REPORT
	1989'	

5/12 Location
 6/9 8" @ 975
 Drlg. 2592'
 7/14 Spud 6-2-54
 Oil Well
 TD 3592'
 8" @ 975'
 Heeb 3229', Tor 3248', Doug 3263',
 Lans 3284', B KC 3510', Reagan 3584'
 TD 3590'
 5" @ 3585'
 CO to 3590'
 B/1 go 2 gwph 2 hrs. 50 M-A
 B/5 go 1 1/2 gwph 5 hrs.
 DD 3592
 B/2 1/2 bo 1 3/4 bw 21 hrs., frac
 S/6 1/2 boph 4 hrs.
 P/87 bo 4 bw
 Comp. 47 bopd

COMPLETED

