

NORTH

WEST

EAST

SOUTH

Rig Up_____

Drilling Remarks

PRODUCTION

1st 24 hrs. Nat.-----

1st 24 hrs. after shot_____

Gas _____cu. ft._____

Dry Hole.....

Abandoned_____

Rush


Map No. KANSAS Sec. 13 Twp. 18 R. 16 W
Well No. 1 Riehl Farm
Schurmerhorn Oil Company

 Ft. from N. Line

1320 Ft. from S. Line

1420 Ft. from E. Line

 Ft. from W. Line

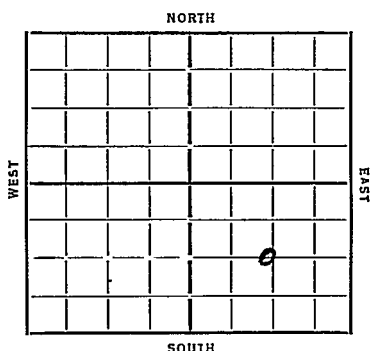

Date 1934 REPORT

9/19 Location

9/27 20" 70 15" 380 WOC

10/4 Sg 710

10/11 " 1180 12 1/2 934

10/18 " 1410

10/25 10" 2097 A. G. 2275-80

A. G. 2290-2315 Sg 2450

11/1 Sg 3150 Lansing 2885

11/8 " 3435 8" 3175 A. G. 3270

11/15 Gas Sand 3456-59

11/21 Gas 3456-59 T-1 3496

46 M Gas.

COMPLETED

KANSAS

Map No. 74 Sec. 13 Twp. 18 R. 16WWell No. 1 - RiedelSchmerhorn O & N Company

Contractor

SECTION PLAT

_____ Ft. from N. Line

1320 Ft. from S. Line1420 Ft. from E. Line

_____ Ft. from W. Line

FIRST REPORTS

Location ✓

Rig up _____

Drilling and Remarks:

RECORD

Cased _____ in., _____ ft.

Sand _____

Gas _____

Oil _____

Total Depth _____

PRODUCTION

1st 24 hrs. Nat. _____

1st 24 hrs. after shot _____

Gas _____ Cu. Ft.

Dry Hole _____

Abandoned _____

Date

9-19-34 19OPTICAL MANNSCHRECK
Scout

Map No. 74 Sec. 13 Twp. 18 R. 16WWell No. 1-ReidlSchermerhorn Company

Contractor

COMPLETED**SECTION PLAT**

_____ Ft. from N. Line

1320 Ft. from S. Line1420 Ft. from E. Line

_____ Ft. from W. Line

Location _____

Rig up _____

Drilling and Remarks:

46 m. 900**RECORD**

Cased _____ in., _____ ft.

Sand _____

Gas 3456-59

Oil _____

Total Depth 3496**PRODUCTION**

1st 24 hrs. Nat. _____

1st 24 hrs. after shot _____

Gas _____ Cu. Ft.

Dry Hole _____

Abandoned _____

Date

11-21-34 19 ORVAL MANNSCHN

Scout