

Section 25 Township 31 Range 2E

Well No. 13 Churchill

Company Shell

Misc.

NORTH

WEST

EAST

0

SOUTH

Sec. 25 Twp. 31 R. 2-E

Well No. #13 Churchill Farm

Shell

Company

Sumner


1150 Ft. from N. Line

 Ft. from S. Line

1000 Ft. from E. Line

 Ft. from W. Line

SW NE SW

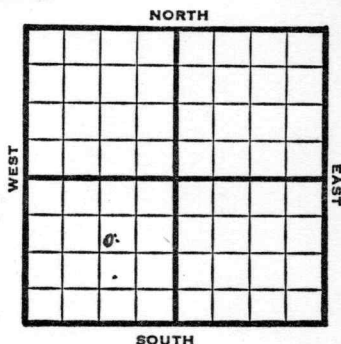

1948 Eli 1164'

REPORT

10/6 Location
10/13 10" @ 150'
10/19 KC 2171'
Drlg. 2261'
10/26 Arbuckle 2631'
TD 2634'
7" @ 2632'
11/3 TD 2650'
1000 acid
Swb 131 bb 1s oil / 2% W 8 hrs.
11/10 TD 2650'
Arb. 2631'
7"@ 2632'
1000 Acid
Pump 198 Oil / 400 W Pot
40° Gr.
Comp

COMPLETED

Map No. _____ Sec. 25 Twp. 31 R. 2EWell No. 13 Churchill

Shell

Company

FIRST REPORT

Contractor

SW NE SW

SECTION PLAT

1150 Ft. from N. Line

_____ Ft. from S. Line

1000 Ft. from E. Line

_____ Ft. from W. Line

Sumner County

Location x

Rig up _____

Drilling and Remarks:

RECORD

Cased _____ in., _____ ft.

Sand _____

Gas _____

Oil _____

Total Depth _____

PRODUCTION

1st 24 hrs. Nat. _____

1st 24 hrs. after shot _____

Gas _____ Cu. Ft.

Dry Hole _____

Abandoned _____

Date

OCT 6 1948

19

S. J. LEWIS

Scout

Map No. 1 Sec. 25 Twp. 31 R. 2E

Well No. 13 Churchill

Shell Company

COMPLETE

Contractor

SW NE SW


21.1164
SECTION PLAT

1150 Ft. from N. Line

 Ft. from S. Line

1000 Ft. from E. Line

 Ft. from W. Line

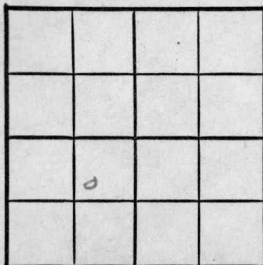

Sumner County

Location

Rig up

Drilling and Remarks:

Cor 82631
7" @ 2632
1000 acid
Pump 198 oil +
400 w Pst
40 = 3/4

RECORD

Cased in., ft.

Sand

Gas

Oil ✓

Total Depth 2650

PRODUCTION

1st 24 hrs. Nat.

1st 24 hrs. after shot

Gas Cu. Ft.

Dry Hole

Abandoned

Date

NOV 10 1948 19

S. J. LEWIS Scout