



Rush

Map No. KANSAS Sec. 14 Twp. 18 R. 16<sup>w</sup>

Well No. 1-Brack Farm  
Alyward et al Company


NORTH

\_\_\_\_\_ Ft. from N. Line

1320 Ft. from S. Line

\_\_\_\_\_ Ft. from E. Line

1320 Ft. from W. Line

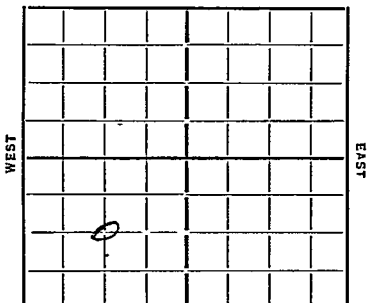

SOUTH

Elev. 1929

Date 1935

REPORT

**O. W. D. D**

8/27 Bldg Reg  
8/15 Road  
8/22 20" 102 15" 400  
8/29 Wlg 865  
9/6 " 2010 12" 963  
10/3 HFW 3325 6" 3434  
 Cong 3479-85 6" 66"  
10/19 Wlg 3478 6" 3461.  
10/17 Sand 3485-3513  
 T.P. 3513  
 40 M Gas.

COMPLETED

OVER

1937

O. W. D. D

8/25

O.T.D. 3513'.  
Drilled 3523' T.D.  
Gauged 44 M gas.  
750# R.P.  
No oil. Killed gas.  
C.O.

9/3

T.D. 3523' SD.

9/10

" " "

9/17

" "b "

9/24

" " "

9/29

Old T.D. 3513'.  
T.D. 3523'.  
44 M gas.

COMPLETED

Map No. 74 Sec. 14 Twp. 18 R. 16W

Well No. 1-Bruck

Alward et al Company

Contractor

**FIRST REPORTS**

..... Ft. from N. Line

1320 Ft. from S. Line

..... Ft. from E. Line

1320 Ft. from W. Line

**SECTION PLAT**


Location..... ✓

Rig up.....

Drilling and Remarks:

Bed Rig

**RECORD**

Cased..... in., ..... ft.

Sand.....

Gas.....

Oil.....

Total Depth.....

**PRODUCTION**

1st 24 hrs. Nat.....

1st 24 hrs. after shot.....

Gas..... Cu. Ft.

Dry Hole.....

Abandoned.....

Date

8-7-35 192

WARRANTY Scout

KANSAS

Map No. 74 Sec. 14 Twp. 18 R. 16W

Well No. 1-Brack

Alward et al Company

Contractor

**FILED**

SECTION PLAT


..... Ft. from N. Line

1320 Ft. from S. Line

..... Ft. from E. Line

1320 Ft. from W. Line

Location.....

Rig up.....

Drilling and Remarks:

40 m. gas

RECORD

Cased..... in. .... ft.

Sand 3485-3513

Gas.....

Oil.....

Total Depth 3513

PRODUCTION

1st 24 hrs. Nat.....

1st 24 hrs. after shot.....

Gas..... Cu. Ft.

Dry Hole.....

Abandoned.....

Date

10-17-35 192.....

ORVAL WANNSCHECK

Scout

*Rush* KANSAS-

Map No. \_\_\_\_\_ Sec. 14 Twp. 18 R. 16W

Well No. 1- Brack

Agliward et al Company

**FIRST REPORT** Contractor

*c sw*

**SECTION PLAT**


\_\_\_\_\_ Ft. from N. Line

1320 Ft. from S. Line

\_\_\_\_\_ Ft. from E. Line

1320 Ft. from W. Line

*OWDD*

Location \_\_\_\_\_

Rig up \_\_\_\_\_

Drilling and Remarks:

*OTD 3513*  
*Drilled 3523+0*  
*Traced 44 M gas*  
*750# R.P.*  
*No oil - Killed gas*  
*S.O.*

**RECORD**

Cased \_\_\_\_\_ in., \_\_\_\_\_ ft.

Sand \_\_\_\_\_

Gas \_\_\_\_\_

Oil \_\_\_\_\_

Total Depth \_\_\_\_\_

**PRODUCTION**

1st 24 hrs. Nat. \_\_\_\_\_

1st 24 hrs. after shot \_\_\_\_\_

Gas \_\_\_\_\_ Cu. Ft.

Dry Hole \_\_\_\_\_

Abandoned \_\_\_\_\_

Date

AUG 25 1937

19

H. D. Hatfield

Scout

Map No. \_\_\_\_\_ Sec. 14 Twp. 18 R. 16WWell No. 1-BrackAylward et al

Company

Contractor

**COMPLETED**

C SW

\_\_\_\_\_ Ft. from N. Line

1320 Ft. from S. Line

\_\_\_\_\_ Ft. from E. Line

1320 Ft. from W. Line

## SECTION PLAT


Location \_\_\_\_\_

Rig up \_\_\_\_\_

Drilling and Remarks:

*OWDD**O.T.D. 3513**T.D. 3523**44 M. gas.*

## RECORD

Cased \_\_\_\_\_ in., \_\_\_\_\_ ft.

Sand \_\_\_\_\_

Gas \_\_\_\_\_

Oil \_\_\_\_\_

Total Depth 3523

## PRODUCTION

1st 24 hrs. Nat. \_\_\_\_\_

1st 24 hrs. after shot \_\_\_\_\_

Gas \_\_\_\_\_ Cu. Ft.

Dry Hole \_\_\_\_\_

Abandoned \_\_\_\_\_

Date

SEP. 14 1937

19

H. D. Hatfield

Scout