


Rush

Form 51-5M-5-34-Palace

Map No. **KANSAS** Sec. 15 Twp. 18 R. 16^w

Well No. 1 Mohr Farm
Jones, Skelly et al Company

NORTH

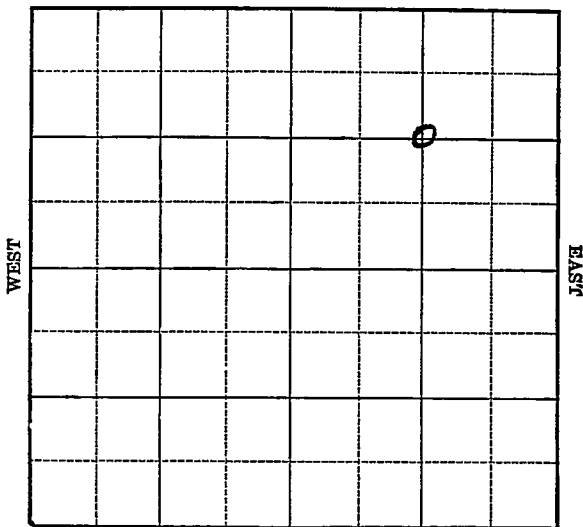

Location _____
Drilling Remarks _____

Rig Up _____
Drilling Remarks _____

RECORD

Cased _____ in. _____ ft.
 Sand _____
 Gas _____
 Oil _____
 Total Depth _____

PRODUCTION

1st 24 hrs. Nat. _____
 1st 24 hrs. after shot _____
 Gas _____ cu. ft. _____
 Dry Hole _____
 Abandoned _____

Rush

Form 252-A
5M 4-32 MPC

Map No. KANSAS Sec. 15 Twp 18 R. 16^w

Well No. 1 Mohr Farm


Texas, Skelly et al Company

1320 Ft. from N. Line

_____ Ft. from S. Line

1320 Ft. from E. Line

_____ Ft. from W. Line

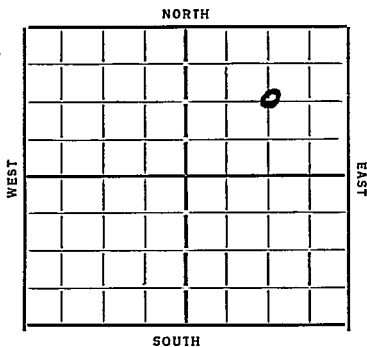

Date 1934

REPORT

6/6	Location		
6/14	—	6/21	— 6/28 —
7/5	—		
7/12	Casing		
7/19	Log		
7/26	Rig		
8/2	—		
8/9	Spud		
8/16	20"	59	15" 383 WOC
8/23	Dly 880		
8/30	977 7' 2" joint 7 pipe		
9/6	Dly	1000	12 1/2 957
9/13	"	1710	
9/20	Run	10"	2225
9/27	Dly 2730		
10/4	Run	8"	3145
10/11	3249 W.R. 8"		
10/18	Dly	3360	8" 3320
10/25	Run	6"	3462 A. G. 3464
10/31	Has	3484-98	TD 3498
	43,000,000 gal.		

COMPLETED

KANSAS

Map No. 74 Sec. 15 Twp. 18 R. 16^W

Well No. 1-Mohr

Tejas, Spelley et al Company

Contractor

FIRST REPORTS

SECTION PLAT

1320 Ft. from N. Line

_____ Ft. from S. Line

1320 Ft. from E. Line

_____ Ft. from W. Line

		⊙	
+ 5			

Location ✓

Rig up _____

Drilling and Remarks: _____

RECORD

Cased _____ in., _____ ft.

Sand _____

Gas _____

Oil _____

Total Depth _____

PRODUCTION

1st 24 hrs. Nat. _____

1st 24 hrs. after shot _____

Gas _____ Cu. Ft.

Dry Hole _____

Abandoned _____

Date

6-6-37 19

ORVAL MANNSCHRECK
Scout


Map No. 94 Sec. 15 Twp. 18 R. 16N

Well No. 1-Mohr

Interstate prod co Company
(Texas, Shelly et al) Contractor

COMPLETED

SECTION PLAT

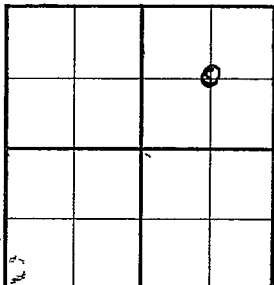

1320 Ft. from N. Line

_____ Ft. from S. Line

1320 Ft. from E. Line

_____ Ft. from W. Line

Location _____

Rig up _____

Drilling and Remarks:

43,000,000
900

RECORD

Cased _____ in., _____ ft.

Sand _____

Gas 3484-98

Oil _____

Total Depth 3498

PRODUCTION

1st 24 hrs. Nat. _____

1st 24 hrs. after shot _____

Gas _____ Cu. Ft.

Dry Hole _____

Abandoned _____

Date

ORVAL MANNSCHNECK
Scout

10-31-34 19