

DX 78-1

Rush

KANSAS

Section 18 Township 18 Range 16W

Well No. #1 Huenergardt

Company Imperial Drlg.

NORTH

16

WEST

EAST

							0

SOUTH

Rush

KANSAS

SEC. 18	TWP. 18	R. 16W
------------	------------	-----------

WELL NO. #1 Huenergardt FARM

COMPANY Imperial Drlg.

CONTRACTOR Harms-Burt


Wildcat

\_\_\_\_\_ Ft. from N. Line

330 \_\_\_\_\_ Ft. from S. Line

330 \_\_\_\_\_ Ft. from E. Line

\_\_\_\_\_ Ft. from W. Line

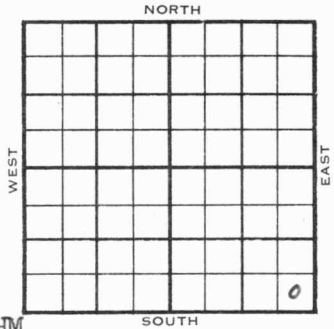

SE SE SE  
Skelly & Phillips - DHM

	ELEVATION	REPORT
1954	1945'	

11/3 Spud 10-29-54  
Anhy 980'  
8" @ 990'

11/23 Drlg. 1385'  
Spud 10-29-54  
D & A

TD 3552'  
Anhy 980'  
8" @ 990'  
Heeb 3179' Lans 3255'  
DST 3258'-78' opn 45 min, rec 280' s.w.  
1110# Reagan 3536' Gr. Wash 3540'  
Gr. 3548'  
TD 3552'  
D & A

ABANDONED



