

Section 19 Township 18 Range 16-W

Well No. 1 Robie

Company L. Wentz

Wildcat

NORTH

13

WEST

EAST

0							

SOUTH

KANSAS

Rush

Sec. 19 Twp. 18 R. 16W

Well No. #1 Robie Farm

L. Wentz Company


Wildcat

         Ft. from N. Line

330 Ft. from S. Line

         Ft. from E. Line

330 Ft. from W. Line

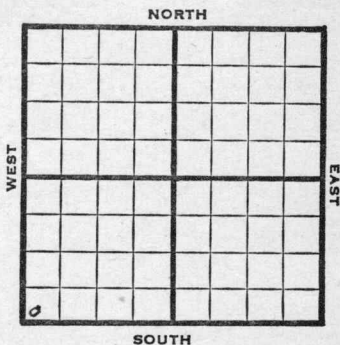

SW/c

1947

Elev. 1996' REPORT

10/8 12" @ 105'

10/15 8" @ 866'  
Drlg. 2405'

10/22 Lans. 3315'  
Basal 3643'  
W. Granite 3663'  
Granite 3668'  
Total Depth 3670'

**ABANDONED**

Map No. \_\_\_\_\_ Sec. 19 Twp. 18 R. 16W

Well No. 1 Robie


L. Wentz Company

FIRST REPORT

Contractor

SW/C

SECTION PLAT

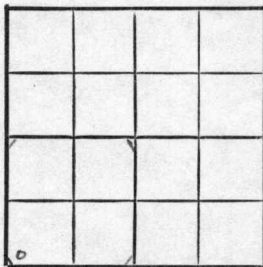

\_\_\_\_\_ Ft. from N. Line

330 \_\_\_\_\_ Ft. from S. Line

\_\_\_\_\_ Ft. from E. Line

330 \_\_\_\_\_ Ft. from W. Line

Rush County

Location \_\_\_\_\_

Rig up \_\_\_\_\_

Drilling and Remarks:

12" @ 105

RECORD

Cased \_\_\_\_\_ in., \_\_\_\_\_ ft.

Sand \_\_\_\_\_

Gas \_\_\_\_\_

Oil \_\_\_\_\_

Total Depth \_\_\_\_\_

PRODUCTION

1st 24 hrs. Nat. \_\_\_\_\_

1st 24 hrs. after shot \_\_\_\_\_

Gas \_\_\_\_\_ Cu. Ft.

Dry Hole \_\_\_\_\_

Abandoned \_\_\_\_\_

Date

OCT 8 1947 19 \_\_\_\_\_

S. J. LEWIS Scout

Map No. 74 Sec. 19 Twp. 18 R. 16W

Well No. 1 Rodie

L. Wentz Company

ABANDONED Contractor

SW/C


E. 1996  
SECTION PLAT

         Ft. from N. Line

330 Ft. from S. Line

         Ft. from E. Line

330 Ft. from W. Line

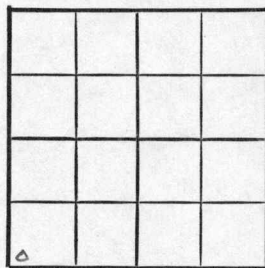

Rush County

Location                                 

Rig up                                 

Drilling and Remarks:

*Lam 8315*  
*Basal 8643*  
*W Granite 8669*  
*Granite 8668*

RECORD

Cased          in.,          ft.

Sand                                 

Gas                                 

Oil                                 

Total Depth 8670

PRODUCTION

1st 24 hrs. Nat.                         

1st 24 hrs. after shot                         

Gas                                  Cu. Ft.

Dry Hole                                 

Abandoned                                 

Date

OCT 22 1947 19

S. J. LEWIS Scout