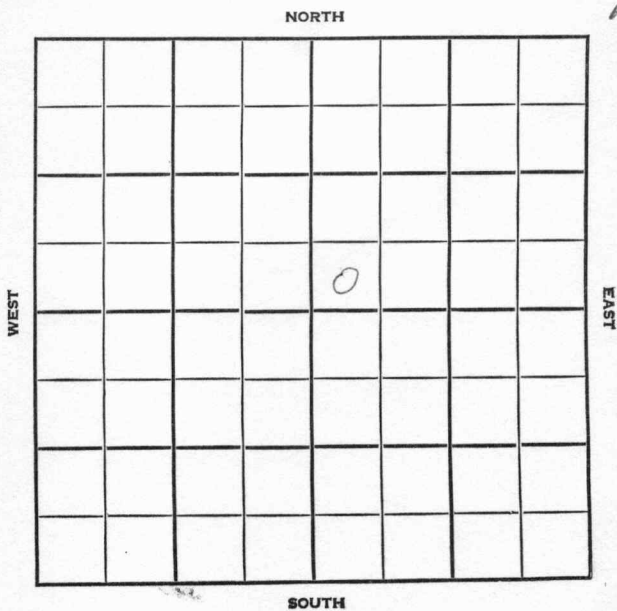


DX 78-1

Rush

KANSAS

Section 20 Township 18S Range 16WWell No. #1 RothCompany Carl Hines, Inc.

Rush

KANSAS

SEC.

20

TWP.

18

R.

16W

WELL NO.

#1 Roth

FARM

COMPANY

Carl Hines, Inc.

CONTRACTOR

Lewsi

Otis-Albert


____ FT. FROM N. LINE

____ FT. FROM S. LINE

____ FT. FROM E. LINE

____ FT. FROM W. LINE

SW SW NE

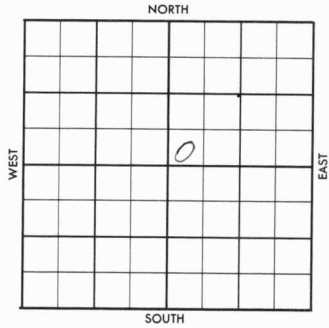

1956

ELEVATION

REPORT

8-8

WORT

COMPLETED

County Rush Elev. _____
Sec. 20 Twp. 18S Rge. 16W
Company Carl Hines, Inc.
Farm Name Roth No. 1

TOPS	DEPTH	LOG	DATUM	Loc. in Sec.
Anh.				SW SW NE
TP.				
H.				
Tr.				
Dg.				
Bl.				
L.				Geol. _____
K.C.				Contr. _____
B.K.C.				
Ce.				Lewis
C.				
M.				
M.				Pool _____
K.				Otis-Albert
Mz.				
Me.				
V.				
S.				
S.				
A.				
R.				
PE.				
G.				
T.D.				

Date Comm. WORT AUG 8 30

14

AUG 18 1938

R. G.

Geol. Waite FO 33034

FORM 513 SUNRAY

County Rush Elev. 1966 DF
 Sec. 20 Twp. 18S Rge. 16W
 Company Carl Mines, Inc.
 Farm Name Roth No. 1

TOPS	DEPTH	LOG	DATUM	Loc. in Sec.
Anh.				SW SW NE
TP.				
H.	3204			
Tr.	3223			
Dg.	3235			
Bl.				
L.	3259			Geo. Waite
K.C.				Geol.
B.K.C.				Contr.
Ce.				
C.				Lewis
M.				
M.				Pool
K.				Otis-Albert
Mz.				
Mq.				
V.				
S.				
S.				
A.				
R. <u>sd</u>	3560			
Pe.				
G.				
TD	3605			COMPLETE

Date Comm.

WORT

AUG 15 '56

Phillips F.O.

8-10-56 8581015

AUG 22 '56

RTD 3605 pipe set.

2 DST

AUG 29 '56

X cird 3563-75 rec.

10 1/2' (SSO) DST 3561-75 op 1 hr?

6 1/3" ga est 150 MCF rec. 10' 080 CM

+ 120' Mdy oil + 70' oil + 50 wtr.

BHP 870/20" cird. 3575-95 rec. 20'

~~est.~~ RTD ~~to~~ 3605 5 1/2 @ 3604

1125 DST 3576-96 op 1 hr rec.

90' OCM + 120' Muddy oil +
70' clean oil + 50' SW BHP 810
CR SEP 5 '58 5 1/2 3604/125 CO 3584
88/3562 = 72 POP P. 40 BO
+ 7 BW 24 hrs SEP 12 '56 P. 28
Bond + 10 To wtr 48 hrs