

KANSAS

Butler County


FORM 51 5M PETROL



Section 6 Township 27 Range 8E

Well No. 1 Gray

Company J. E. Morris etal

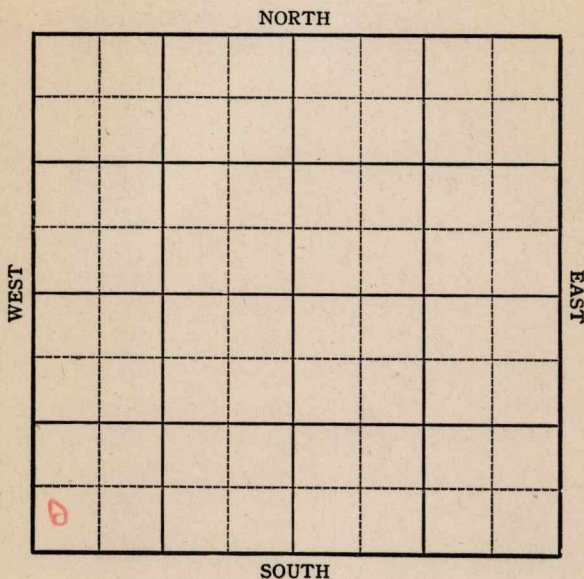

KANSAS

Butler

Sec. 6 Twp. 27 R. 8E

Well No. 1 Gray Farm

J. E. Morris etal Company

Miscellaneous

 Ft. from N. Line

990 Ft. from S. Line


330 Ft. from E. Line

 Ft. from W. Line

of Lot 23

lot 23

aw/c Lot 23

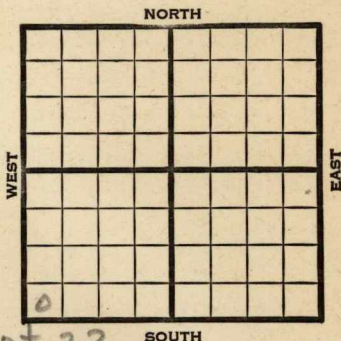

1945

Elev. 1509

R E P O R T

5/16

205'

5/24

15" @ 265

12" @ 450

Drlg. 800'

5/31

Drlg. 1410'

6/13

Bart

2625

Miss

2719

7" @ 2720'

Td 2764'

ABANDONED

Kansas Pool Name MiscellaneousMap No. 10 Sec. 6 Twp. 27 R. 8^EWell No. 1 GrayJ. E. Morris et al Company

FIRST REPORT

Contractor


lot 23

SECTION PLAT

 Ft. from N. Line990 Ft. from S. Line330 Ft. from E. Line Ft. from W. Line

of Lot 23

Butler County

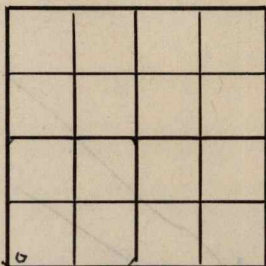Location Rig up

Drilling and Remarks:

205'

RECORD

Cased in., ft.Sand Gas Oil Total Depth

PRODUCTION

1st 24 hrs. Nat. 1st 24 hrs. after shot Gas Cu. Ft.Dry Hole Abandoned

Date

MAY 16 1945 19S. J. LEWIS

Scout

Kansas Pool Name Miscellaneous

Map No. 10 Sec. 6 Twp. 27 R. 8E

Well No. 1 Gray

J. E. Morris etal Company

ABANDONED

Contractor

Lot 23

E. 1, 1509
SECTION PLAT

6			1

 Ft. from N. Line

990 Ft. from S. Line

330 Ft. from E. Line

 Ft. from W. Line

Butler County

Location

Rig up

Drilling and Remarks:

Bar 2625

Miss 2719

7" @ 2720

RECORD

Cased in., ft.

Sand

Gas

Oil

Total Depth 2764

PRODUCTION

1st 24 hrs. Nat.

1st 24 hrs. after shot

Gas Cu. Ft.

Dry Hole

Abandoned

Date

JUN 1 3 1945

19

S. J. LEWIS Scout