

Sumner


KANSAS

FORM 51 5M PETROL

Section 25 Township 31 Range 2E

Well No. 12 W. C. Churchill

Company Shell

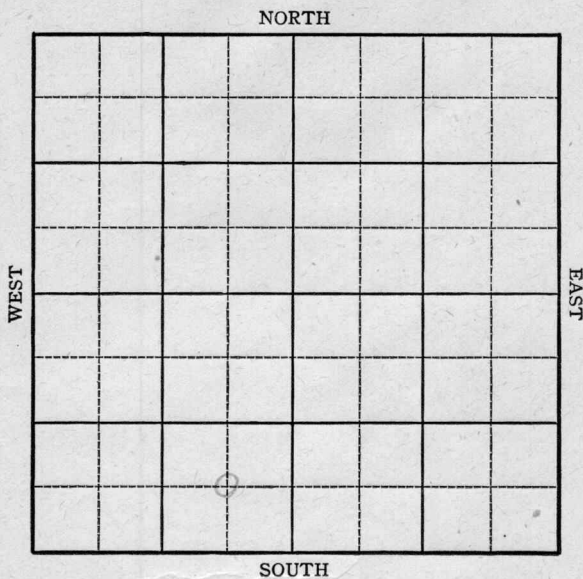

KANSAS

Summer

Sec. 25 Twp. 31 R. 2-E

Well No. #12 W. C. Churchill Farm


Shell Company

Ft. from N. Line

699 Ft. from S. Line

590 Ft. from E. Line

Ft. from W. Line

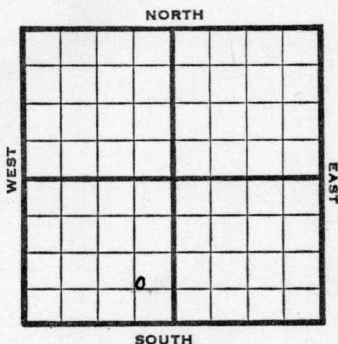

1945 Elev. 1161

REPORT

9/19 8" @ 162'

9; 26 Hoover 1675
Tonkawa 1830

Drlg. 2139

10/3 Lans 2406 S.D.

10/10 Arb. 2632-2657

TD 2657

4" @ 2634 RUST

10/17 Flow 320 oil plus 18 Wtr. in 24 hrs.

10/24 " " " " " "

10/31 " " " " " "

11/7 " " " " " "

11/14 " " " " " "

11/21 Arb. 2632

4" @ 2634

TD 2657

Pump/26 oil plus 40 Wtr. Pot.

Grav. 40.0

COMPLETED

KANSAS

Kansas Pool Name ChurchillMap No. 1 Sec. 25 Twp. 31 R. 2EWell No. 12 W. C. Churchill

Shell

Company

FIRST REPORT

Contractor

C E L SE SW

SECTION PLAT

	0		

 Ft. from N. Line699 Ft. from S. Line590 Ft. from E. Line Ft. from W. Line

Sumner County

Location Rig up

Drilling and Remarks:

8"-152'

RECORD

Cased in., ft.Sand Gas Oil Total Depth

PRODUCTION

1st 24 hrs. Nat. 1st 24 hrs. after shot Gas Cu. Ft.Dry Hole Abandoned

Date

SEP 19 1945

19

S. J. LEWIS

Scout

KANSAS

Pool Name ChurchillMap No. 1 Sec. 25 Twp. 31 R. 2EWell No. 12 W. C. Churchill

Shell

Company

CORRECTION

Contractor

C SE SW

SECTION PLAT

_____ Ft. from N. Line

699 Ft. from S. Line590 Ft. from E. Line

_____ Ft. from W. Line

Sumner County

Location _____

Rig up _____

Drilling and Remarks:

reported C E L SE SW

RECORD

Cased _____ in., _____ ft.

Sand _____

Gas _____

Oil _____

Total Depth _____

PRODUCTION

1st 24 hrs. Nat. _____

1st 24 hrs. after shot _____

Gas _____ Cu. Ft.

Dry Hole _____

Abandoned _____

Date

SEP 19 1945 19

S. J. LEWIS

Scout

KANSAS

Kansas

Pool Name Churchill

Map No. 1 Sec. 25 Twp. 31 R. 2EWell No. 12 W. C. Churchill

Shell

Company

COMPLETED

Contractor

C SE SW

E11161

SECTION PLAT

Ft. from N. Line

699 Ft. from S. Line590 Ft. from E. Line

Ft. from W. Line

Sumner County

Location

Rig up

Drilling and Remarks:

Cr 72632

4" C 02634

Pump 126026 + 40W
Pot

40° S

RECORD

Cased _____ in., _____ ft.

Sand _____

Gas _____

Oil _____

Total Depth 2657

PRODUCTION

1st 24 hrs. Nat. _____

1st 24 hrs. after shot _____

Gas _____ Cu. Ft.

Dry Hole _____

Abandoned _____

Date

NOV 21 1945

19

S. J. LEWIS

Scout