


Summer

Map No. KANSAS Sec. 25 Twp. 31 R. 2^E

Well No. 1- Herrick Farm
W.K. Mann Company

NORTH

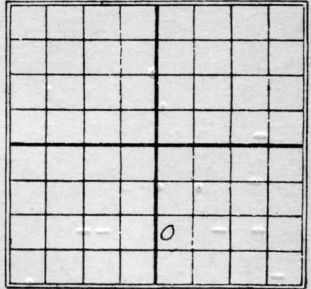

_____ Ft. from N. Line

910 Ft. from S. Line

_____ Ft. from E. Line

200 Ft. from W. Line

1930

Date _____ REPORT **O.W.D.D**

5/21	Loc.
5/28	—
6/4	—
6/11	—
6/18	Sand
6/25	Drly. 300'
7/2	" 450'
7/9	" 875'
7/16	8" - 875'
7/23	Drly. 930'
7/30	" 1070'
8/6	SD. 1200'
8/13	Drly 1575'
8/20	" 1640'
8/27	Sand 1853-1879' Show free oil - will shoot.
9/3	—
9/10	Sand 1853-80 T.D. 1880' shot 50 gal Made 55 bbl oil & Comp. 120 " water

OVER

1936

O. W. D. D

3/4 Material

- 3/13 Rign.
3/20 Drlg. 1865'
3/27- Drlg 1890'
4/2- T.D. 1930' Pulling big pipe.
4/10- - 4/16--4/23--4/30--
5/7-Cleaning out.
5/14- Drlg. 1962'.
5/21-Drlg. 2080'.
6/4-Drlg. 2162'.
6/11-Drlg. 2218'.
6/18-600' of oil. Fishing.
6/25-Swab 25 bbls of oil in 18 hours.
Shut down.
7/2-- ~~7/9~~
7/9-1000 gallons of acid. No test.
7/16--
7/22/36-KCL 2151'.
T.D. 2218.
1000 gallons of acid.
Potential 160 bbls of oil.

COMPLETED

Summer

Map No. **KANSAS** Sec. *25* Twp. *31* R. *2^E*

Well No. *1* *Herrick*
H. K. Mann Company

Contractor

FIRST REPORTS

SECTION PLAT

_____ Ft. from N. Line

910 Ft. from S. Line

_____ Ft. from E. Line


700 Ft. from W. Line

		0	

Location

Rig up _____

Drilling and Remarks:

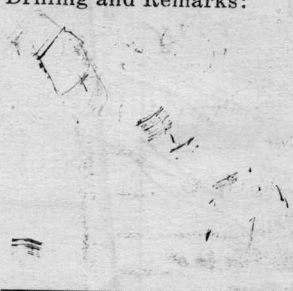

RECORD

Cased _____ in., _____ ft.

Sand _____

Gas _____

Oil _____

Total Depth _____

PRODUCTION

1st 24 hrs. Nat. _____

1st 24 hrs. after shot _____

Gas _____ Cu. Ft.

Dry Hole _____

Abandoned _____

Date

MAY 21 1930

CHAS. L. SHERWOOD

19

Scout

Summer

Map No. **KANSAS** Sec. *25* Twp. *31* R. *2^E*

Well No. *1* *Herrick*

W.H. Mann Company

Contractor

COMPLETE

SECTION PLAT

..... Ft. from N. Line
910 Ft. from S. Line
..... Ft. from E. Line
700 Ft. from W. Line

		<i>0</i>	

Location.....

Rig up.....

Drilling and Remarks:

50/55 lbs oil
120 " water

RECORD

Cased..... in., ft.
Sand *1853-1880*
Gas.....
Oil.....
Total Depth *1880*

PRODUCTION

1st 24 hrs. Nat.....
1st 24 hrs. after shot.....
Gas..... Cu. Ft.
Dry Hole.....
Abandoned.....

Date

SEP 10 1930

CHAS. L. SHERWOOD

192.....

Scout

Map No. 1 Sec. 25 Twp. 31 R. 2 E

Well No. 1-Herrick

W. K. Mann et al Company

Contractor

FIRST REPORTS

Cudd

SECTION PLAT

..... Ft. from N. Line

910 Ft. from S. Line

..... Ft. from E. Line

290 Ft. from W. Line

Location.....

Rig up.....

Drilling and Remarks:

OTD 1879

material

RECORD

Cased..... in., ft.

Sand.....

Gas.....

Oil.....

Total Depth.....

PRODUCTION

1st 24 hrs. Nat.....

1st 24 hrs. after shot.....

Gas..... Cu. Ft.

Dry Hole.....

Abandoned.....

Date

ORVAL MANNSCHRECK

3-4-36

192.....

Scout

Sumner

Map No. 1 Sec. 25 Twp. 31 R. 24

Well No. 1 *Herrick*

H. K. Mann Company

Contractor

SECTION PLAT

		0	

_____ Ft. from N. Line

910 Ft. from S. Line

_____ Ft. from E. Line

200 Ft. from W. Line

COMPLETED

Location _____

Rig up _____

Drilling and Remarks:

KOL 2151

1000 acid

Prod 160 H/c

RECORD

Cased _____ in., _____ ft.

Sand _____

Gas _____

Oil _____

Total Depth 2218

PRODUCTION

1st 24 hrs. Nat. _____

1st 24 hrs. after shot _____

Gas _____ Cu. Ft.

Dry Hole _____

Abandoned _____

Date

JUL 22 1936

19

S. J. LEWIS

Scout