


Rush

KANSAS
16W

SECTION 21 TOWNSHIP 18 RANGE _____

WELL NO. W #3 Lenora Miller

COMPANY Skelly Oil

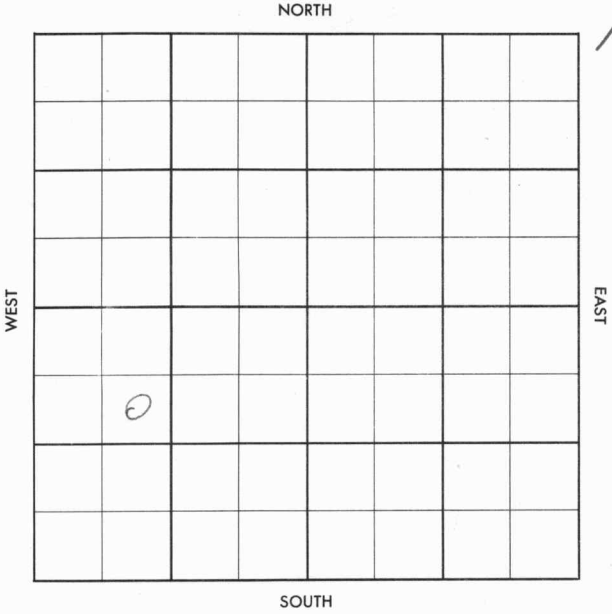

Rush

KANSAS

| | | |
|------------|------------|-----------|
| SEC. 21 | TWP. 18 | R. 16W |
|------------|------------|-----------|

WELL NO.

#3 Lenora Miller

FARM

COMPANY

Skelly Oil

CONTRACTOR

Wentworth

~~Otis-Albert~~


_____ Ft. from N. Line

_____ Ft. from S. Line

_____ Ft. from E. Line

_____ Ft. from W. Line

SE NW SW

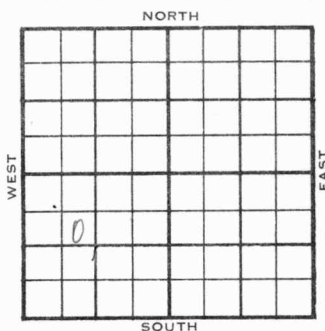

1956

ELEVATION
1989 EL.

REPORT

4-18

Loc.

6-13

Comm. 4-18-56
 8 5/8" @ 1039 w/500
 crd. 3575
 DST 3573-3608 1 hr. g in 4" g a
 200 mcf rec. 250' ocm
 BHP 800
 5 1/2" @ 3622 w/125
 CO 3613
 132/3578-3600
 ∅ 10 go ∅ 15 gwph 2 hrs.
 ∅ 20 go ∅ 34 gw in 2 hrs.
 PB 3595
 Frac ∅ 60 bo ∅ 20 bw 20 hrs.
 ∅ 26 bo ∅ 68 bw /24
 p. 26 bo ∅ 52 bw /24
 Any. 1030', H. 3227', Tr. 3246',
 Sd. 3259', L. 3285', R. Sd. 3577',
 Pr. Cl. 3601',
 TD 3623'

COMPLETED

County Rush Elev. _____
 Sec. 21 Twp. 18 Rge. 16W
 Company Skelly Oil
 Farm Name Lenora Miller No. 3

| TOPS | DEPTH | LOG | DATUM |
|--------|-------|-----|-------|
| Anh. | | | |
| TP. | | | |
| H. | | | |
| Tr. | | | |
| Dg. | | | |
| Bl. | | | |
| L. | | | |
| K.C. | | | |
| B.K.C. | | | |
| Ce. | | | |
| C. | | | |
| M. | | | |
| M. | | | |
| K. | | | |
| Mz. | | | |
| Me. | | | |
| V. | | | |
| S. | | | |
| S. | | | |
| A. | | | |
| R. | | | |
| PE. | | | |
| G. | | | |
| TD. | | | |

Loc. in Sec. SE NW SW
 Geol. _____
 Contr. Wentworth
 Pool Otis-Albert

| | | | |
|--|--|--|--|
| | | | |
| | | | |
| | | | |
| | | | |

FIRST REPORT
 APR 18 58

Date Comm. _____
 Location Location

[Handwritten signature]

WBR 5.4.1958

R. G.

Co.
 Lsc.
 No.
 Ser.
 T.
 R.

County Rush Elev. 1989
 Sec. 21 Twp. 18 Rge. 16W
 Company Skelly Oil
 Farm Name Lenora Miller No. 3

| TOPS | DEPTH | LOG | DATUM | Loc. in Sec. |
|-------------------|-------|-----|-------|------------------------|
| Anh. | 1030 | | | SE NW SW |
| TP. | | | | |
| H. | 3227 | | | |
| Tr. | 3246 | | | |
| Dg. <u>2d</u> | 3259 | | | |
| BL. | | | | |
| L. | 3285 | | | |
| K.C. | | | | Geol. |
| B.K.C. | | | | Contr. |
| Ce. | | | | Wentworth |
| C. | | | | |
| M. | | | | Pool |
| M. | | | | Otis-Albert |
| K. | | | | |
| Mr. | | | | |
| Mq. | | | | |
| V. | | | | |
| S. | | | | |
| S. | | | | |
| A. | | | | |
| R. <u>3d</u> | 3577 | | | COMPLETE JUN 13 '56 |
| PE. <u>Pr. 66</u> | 3601 | | | |
| G. | | | | |
| TD. | 3623 | | | |

Date Comm. _____
 Location APR 25 '56 4-18-56 85/8
 1039/500 @ 1800 MAY 2 '56 CRD
 3575 MAY 9 '56 DST 3573-3608 1hr
 9 in 4" ga 200 MCF rec 250'
 OCM BHP 800 5 1/2 @ 3622/125
 CO 3613 132/3578-3600 @ 1090
 +15 Gwph 2 hrs/1/4 @ 2090 +
 34 gw in 2 hrs PB 3595 MAY 16 '56
 Frac \$ 60 B0 + 20 BW 20 hrs

27-19-10W

SENIOR SW

MAY 23 '56

MAY 29 '56

JUN 7 '56

A 2600 + 68 BW / 24 JUN 13 '56
P 2600 + 52 BW / 24