

Barton

KANSAS

SECTION 14 TOWNSHIP 20S RANGE 12W

WELL NO. #2 Buckbee


COMPANY Alpine Oil & Royalty

NORTH

N/2 SE NW

WEST

EAST

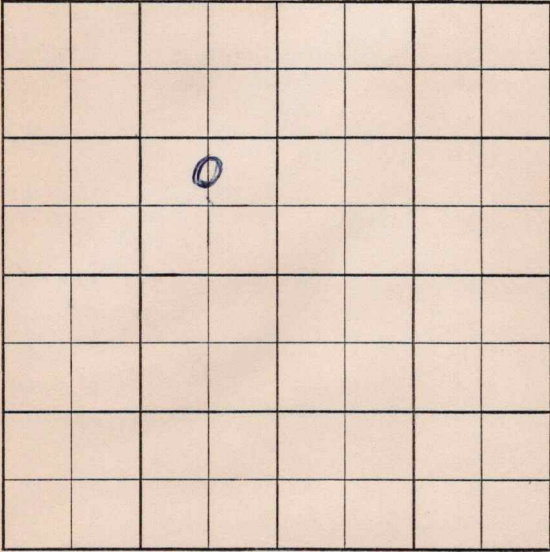

SOUTH

555545


13

S-513-B

County Barton Elev. _____
Sec. 14 Twp. 20 Rge. 12W
Company Alpine Oil & Royalty
Farm Name Buckbee No. 2

TOPS	DEPTH	LOG	DATUM
Anh.			
Tp.			
H.			
Tr.			
Dg.			
B.L.			
L.			
K.C.			
B.K.C.			
Ce.			
C.			
M.			
M.			
K.			
Mz.			
Mq.			
V.			
S.			
S.			
A.			
R.			
Pf.			
G.			
T.D.			

Loc. in Sec. _____
N/2 SE NW
Geol. _____
Contr. _____
Quaker #2
Pool _____
Buckbee

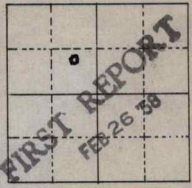

Date Comm. _____

Location

Co.
Lse.
No.
Sec.
T.
R.

County Barton Elev. 1825 DF 1808 AB
 Sec. 14 Twp. 20 Rge. 12W
 Company Alpine Oil & Royalty
 Farm Name Buckbee (Lizzie) No. 2

TOPS	DEPTH	LOG	DATUM	Loc. in Sec.
Anh.	<u>575</u>			<u>N/2 SE NW</u>
Tp.				
H.	<u>2984</u>			
Tr.				
Dg.				
B.L.	<u>3109</u>			
L.	<u>3126</u>			
K.C.				Geol.
B.K.C.	<u>3353</u>			Contr.
Ce.				
C.	<u>3369</u>			<u>Quaker #2</u>
M.				Pool
M.				<u>Buckbee</u>
K.				
Mz.				
Mq.				
V.				
S.				
S.				
A.	<u>3387</u>			
R.				
Pf.				
G.				
T.D.	<u>3408</u>			

MAR 12 '58		
0		
ABANDONED		

Date Comm. 2-25-58

Location MAR 5 '58 8" 178/200 PST

3140-90 60" 10'M USSO BHP 20

DST 3198-3245 60" 10'M BHP

430 DST ~~3245-3306~~ MAR 12 '58 PST

3245-3306 60" 10'M USSO

BHP 0 DST 3387-3400 60" 10'M

USSO BHP 890/20" DST 3400-08

60" 48' SW BHP 890 no Log

D & A