
Rush KANSAS

SECTION 21 TOWNSHIP 18 RANGE 16 W

WELL NO. #1 Munson (Manson ?)

COMPANY Solar Oil

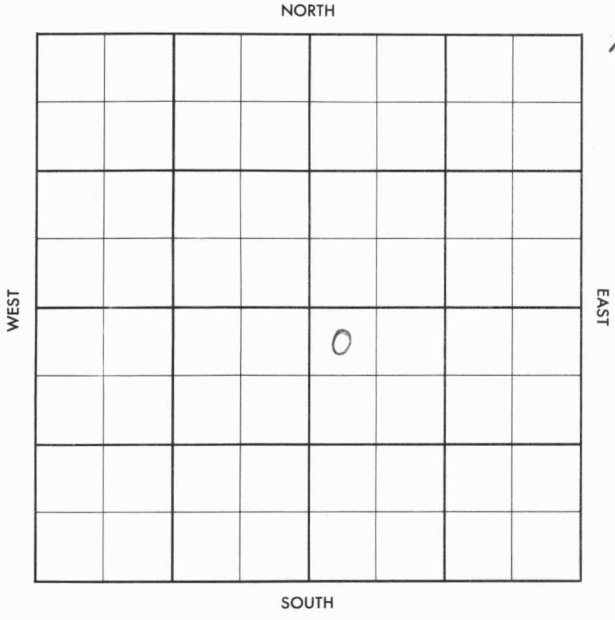

FORM 504-3 SUNRAY

Rush KANSAS

SEC.	TWP.	R.
21	18	16W

WELL NO.

#1 Munson FARM

COMPANY

Solar Oil

CONTRACTOR

D & M

Otis-Alberb


_____ Ft. from N. Line

_____ Ft. from S. Line

_____ Ft. from E. Line

_____ Ft. from W. Line

NW NW SE

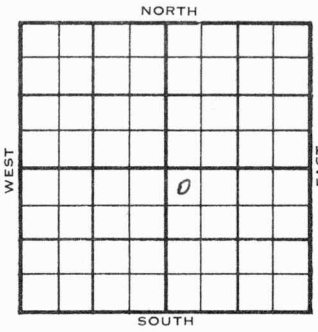

1955	ELEVATION 1971'	REPORT
10/26	Comm 10-23-55 8 5/8" @ 1031/400 WOC	
11-16	5½" @ 3595/75 39/ 3555-61 FU 1050' oil 14 hr. Comp. # 35 bo pd	

Tops:	Depth	log
Anh	1021	
H.	3224	3204
L.	3275	3262
Reagan		3550
Gtz.		3590

T.D. 3597'

COMPLETED

DX-78

FORM 513 REV. SUNRAY

County Rush Elev.

Sec. 21 Twp. 18 Rge. 16W

Company Solar Oil

Farm Name Munson No. 1

TOPS	DEPTH	LOG	DATUM
Anh.			
T.P.			
H.			
Tr.			
Dg.			
B.L.			
L.			
K.C.			
B.K.C.			
Ce.			
C.			
M.			
M.			
K.			
Mz.			
Mo.			
V.			
S.			
S.			
A			
R.			
P€.			
G.			
T.D.			

Loc. in Sec. NW NW SE

Geol.

Contr. D & M

Pool Otis-Albert

FIRST REPORT

OCT 26 '55

Date Comm. 10-23-55

8 5/8" @ 1031/400 WOC

Co. Lse. No. Sec. T. R.

FORM 513 REV. SUNRAY

County Rush Elev. 1971

Sec. 21 Twp. 18 Rge. 16W

Company Solar Oil

Farm Name Munson No. 1

TOPS	DEPTH	LOG	DATUM
Anh.	1021		
Tp.			
H.	3224	3204	1233
Tr.			
Dg.			
B.L.			
L.	3275	3262	1291
K.C. Reagan		3550	1579
B.K.C. gtz		3590	1619
Ce.			
C.			
M.			
M.			
K.			
Mz.			
Mo.			
V.			
S.			
S.			
A			
R.			
P€.			
G.			
T.D.	3577		

Loc. in Sec. NW NW SE

Geol.

Contr. D & M

Pool Otis-Albert

COMPLETE

Date Comm. 10-23-55 NOV 16 1955

8 5/8" @ 1031/400 5½" @ 3595/75

39/ 3555-61 FU 1050' oil 1¼ hr.

Comp. 35 bopd

Co. Lse. No. Sec. T. R.