Form 51—5M—3-26—22544

Map No. Kansas Sec. 15 Twp. 31 R. 1 E

Well No. 1 Mason Farm

Roxana Pet Company

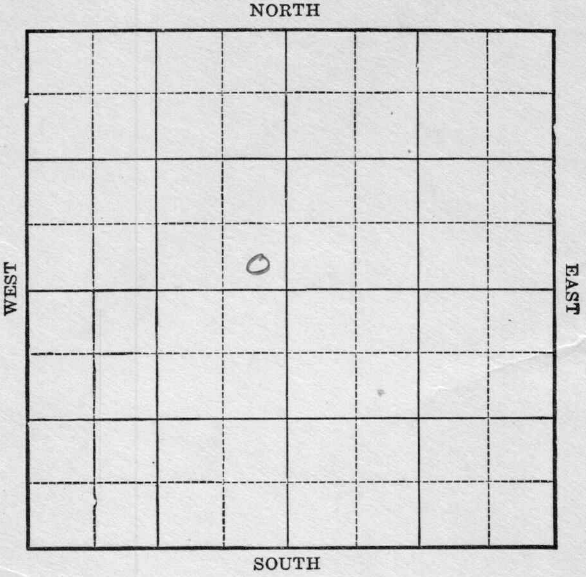

Location

Drilling Remarks

RECORD

Cased in. ft.

Sand

Gas

Oil

Total Depth

Rig Up

Drilling Remarks

PRODUCTION

1st 24 hrs. Nat.

1st 24 hrs. after shot

Gas cu. ft.

Dry Hole

Abandoned

Form 252A—5M—11-25—20913 Sumner Co

Map No. Kansas Sec. 25 Twp. 31 R 2E

Well No. 1 Mason Farm

Rotana Pet Company

Ft. from N. Line

330 Ft. from S. Line

330 Ft. from E. Line

Ft. from W. Line

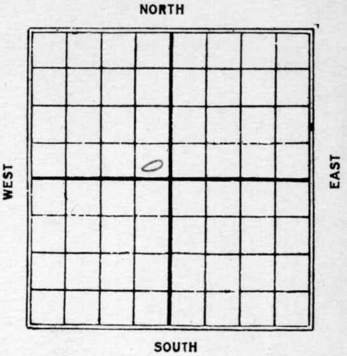

Date 1926	REPORT
7/9	Bldg Rig
7/22	Spud
7/28	Dlg 380
8/4	" 990
8/11	" 1592
8/18	Z 1839 - Pay 1871 - 1882 - T.D. 1882
	Swabbed 343 bbls 24 hrs.
8/25	Z 1839 Oil 1871
	T.D. 1885 Swabbed
	343 bbls 24 hrs
	Shot 40 qts flowed
	1281 bbls 13 hrs (

Form 26—1M Bks.—3-23—11959.

Sumner Co

K1

Map No. KANSAS Sec. 25 Twp. 31 R. 2 E

Well No. 1 Mason

Roxana Pet Corp Company

Contractor

FIRST REPORTS

Ft. from N. Line

330 Ft. from S. Line

330 Ft. from E. Line

Ft. from W. Line

SECTION PLAT

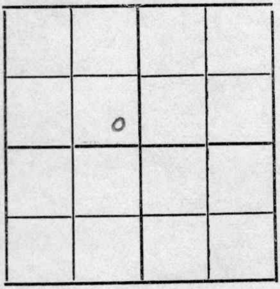

Location

Rig up

Drilling and Remarks:

Bldg Rig

RECORD

Cased in., ft.

Sand

Gas

Oil

Total Depth

PRODUCTION

1st 24 hrs. Nat.

1st 24 hrs. after shot

Gas Cu. Ft.

Dry Hole

Abandoned

Date

JUL 9 1926 192

CHAS. L. SHERWOOD Scout

Form 26—1M Bks.—3-23—11959.

Sumner

K I

Map No. **KANSAS** Sec. 25 Twp. 31 R. 2E.

Well No. 1 Mason

Roxana Pet. Corp. Company

Contractor

SECTION PLAT

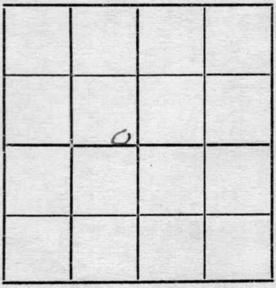

Ft. from N. Line

330 Ft. from S. Line

330 Ft. from E. Line

Ft. from W. Line

FIRST REPORTS

Location

Rig up

Drilling and Remarks:

Rigging up.

RECORD

Cased in., ft.

Sand

Gas

Oil

Total Depth

PRODUCTION

1st 24 hrs. Nat.

1st 24 hrs. after shot

Gas Cu. Ft.

Dry Hole

Abandoned

Date

JUL 14 1926 192

S. J. LEWIS Scout

Form 26—1M Bks.—3-23—11959.

Sumner

Map No KANSAS Sec. 25 Twp. 31 R. 2E.

Well No. 1 Mason

Roxana Pet Corp. Company

Contractor

SECTION PLAT

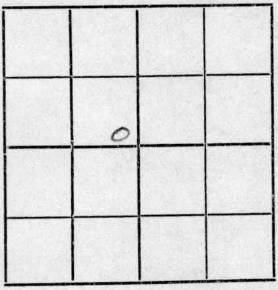

Ft. from N. Line

330 Ft. from S. Line

330 Ft. from E. Line

Ft. from W. Line

COMPLETED

Location

Rig up

Drilling and Remarks:

T.S. 1839
Oil 1871
T.D. 1885
swabbed 343 bbls
24 hrs.
shot 40 qts 1865
1885
Flowed 1281 bbls
18 hrs.

Date

AUG 25 1926 192

RECORD

Cased in., ft.

Sand

Gas

Oil

Total Depth

PRODUCTION

1st 24 hrs. Nat.

1st 24 hrs. after shot

Gas Cu. Ft.

Dry Hole

Abandoned

S. J. LEWIS Scout