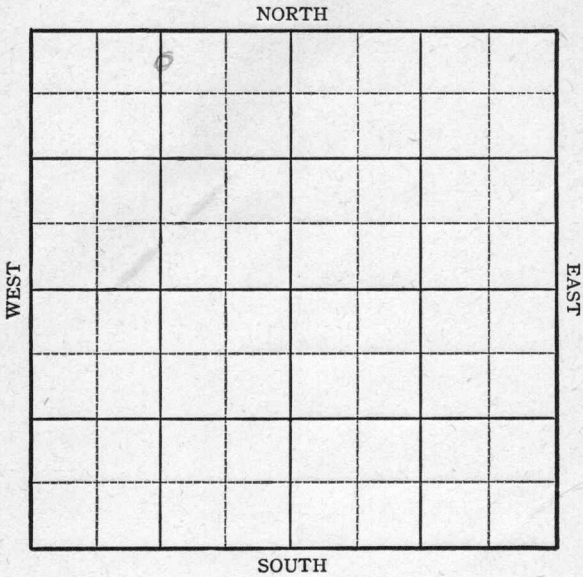


Section 16 Township 20 Range 9WWell No. 3 Argo-SmithCompany Bay Pet.

Sec. 16 Twp. 20 R. 9-W

Well No. #3 Argo-Smith Farm


Bay Pet. Company

330 Ft. from N. Line

 Ft. from S. Line

1320 Ft. from E. Line

 Ft. from W. Line

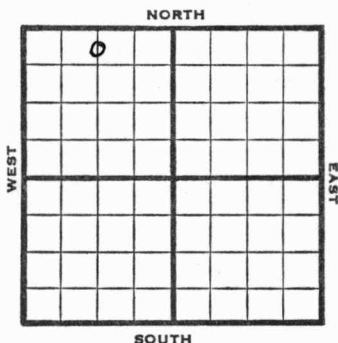

C N L NW

1945 Elev. 1740 REPORT

10/3 Location
10/17 Drlg. 2552
10/24 Lans 2925
Arb. 3248
TD 3250
7" @ 3249 RUST
10/31 TD 3255
150' oil 12 hrs.
11/7 Swab 5 oil per hr.
11/14 8" @ 19" "
11/21 " " "
11/28 " " "
12/5 Arb. 3248
7" @ 3249
TD 3262
Pump 100 Pot.
Grav. 42.0

COMPLETED

KANSAS

Pool Name SilicaMap No. 49 Sec. 16 Twp. 20 R. 9 WWell No. 3 Argo-Smith

Bay Pet.


Company

FIRST REPORT

Contractor

C N L NW

SECTION PLAT

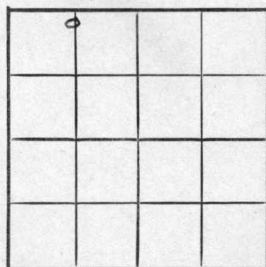330 Ft. from N. Line Ft. from S. Line1320 Ft. from E. Line Ft. from W. LineRice CountyLocation XRig up

Drilling and Remarks:

RECORD

Cased in., ft.Sand Gas Oil Total Depth

PRODUCTION

1st 24 hrs. Nat. 1st 24 hrs. after shot Gas Cu. Ft.Dry Hole Abandoned

Date

OCT 3 1945 19

S. J. LEWIS

Scout

KANSAS

Kansas Pool Name SilicaMap No. K219 Sec. 16 Twp. 20 R. 9WWell No. 3 Argo-Smith

Bay Pet. _____

Company _____

COMPLETED

Contractor _____

C N L NW


E 11740
SECTION PLAT330 Ft. from N. Line

_____ Ft. from S. Line

1320 Ft. from E. Line

_____ Ft. from W. Line

Rice County

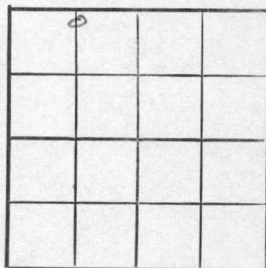

Location _____

Rig up _____

Drilling and Remarks:

Cu 32487" C 3248Pump 100 PD42 1/2

RECORD

Cased _____ in., _____ ft.

Sand _____

Gas _____

Oil _____

Total Depth 32.62

PRODUCTION

1st 24 hrs. Nat. _____

1st 24 hrs. after shot _____

Gas _____ Cu. Ft.

Dry Hole _____

Abandoned _____

Date

DEC 5 1945

19

S. J. LEWIS Scout